DIR	MILEPOINT	LOCATION CODE (SHEET 2)	MUTCD CODE	WIDTH (IN)	HEIGHT (IN)	SHEETING REMARKS	SIGN LEGEND FOR POST LENGTHS AND INSTALLATION DATES SEE ORIGINAL RECORD PLANS	NEW SIGNS "A"	NEW SIGNS "B"	EXISTING SIGNS RETAIN	EXISTING SIGNS SALVAGE FROM	EXISTING SIGNS SALVAGE TO	EXISTING SIGNS REMOVE	EXIST POST RETAIN	EXIST POST REMOVE	NUMBER OF NEW POSTS	SQUARE STEEL (in) 2.00 (LB / FT) 2.16	SQUARE STEEL (in) 2.00 (LB / FT) 2.42	SQUARE STEEL (in) 2.50 (LB / FT) 3.35	TUBULAR STEEL Ø (IN) FOUNDATION	TUBULAR STEEL Ø (IN) 3.00 (LB / FT) 7.60	TUBULAR STEEL Ø (IN) 3.50 (LB / FT) 9.00	TUBULAR STEEL Ø (IN) 4.00 (LB / FT) 10.80	TUBULAR STEEL Ø (IN) 5.00 (LB / FT) 14.60	SIGN FRAME REQUIRED	REMARKS	SIGN DETAIL: DETAIL IN SHS	SIGN DETAIL: DETAIL ON SHEET NUMBER	SIGN DETAIL: DETAIL ON STD SHEET NUMBER
WINHALL VT11							"FY"-FLUORESCENT YELLOW "FYG"-FLUORESCENT YELLOW GREEN																			"SHS"-STANDARD HIGHWAY SIGNS			
		F	M1-5A	24	24								1																
		F	M3-4	24	12		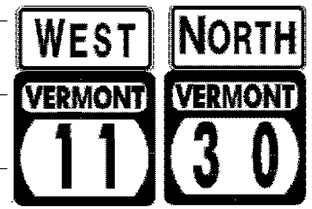	2.00								2		X						#1			7	E-136B
		F	M1-5A	24	24			4.00																					E-136B
		F	M3-1	24	12			2.00																					E-136B
		F	M1-5A	24	24			4.00																					E-136B
WB	2.981	F	D2-1	72	10						1		1		X												BRIDGE PLAQUE			
		F	D2-1	72	12		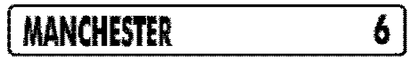	6.00				1				2		X								5	
WB	2.941	F	R2-1	24	30								1		X															
		F	R2-1	24	30			5.00								1		X									X		
WB	2.779	F	W11-6H	30	30		SNOWMOBILE			1				X															
WB	2.740	F	W16-9	24	10	FYG	AHEAD PLAQUE			1				X															
		F	W11-2	30	30	FYG	PEDESTRIAN WARNING SIGN			1																			
WB	2.702	F	VR-020	24	30		NO PARKING ON TRAVELLED LANES			1				X															
WB	2.635	F	W11-2	30	30	FYG	PEDESTRIAN WARNING SIGN			1				X															
		F	W16-7	24	12	FYG	DOWN ARROW PLAQUE			1																			
SIGN SUMMARY SHEET							SHEET TOTALS	23.00	0.00	6	~~0~~ 1	~~0~~ 1	3	0	0	5		75										
								SF	SF	EA	EA	EA	EA	EA	EA	EA		FT										
VERMONT AGENCY OF TRANSPORTATION							TOWN TOTALS	524.2	0.0	15.0	0.0	0.0	118	2.0	2.0	76		1140.0										

PROJECT NAME: Manchester-Springfield VT11
PROJECT NUMBER: STPG SIGN(25)
FILE NAME: Winhall VT11.xls
PROJECT MANAGER: N. Avery
DESIGNED BY: A. Gamble
WINHALL SHEET 12
PLOT DATE: 4/6/2009
DRAWN BY: T. Guazzoni
CHECKED BY: S. Menard
SHEET 23 OF 115