DIR	MILEPOINT	LOCATION CODE (SHEET 2)	MUTCD CODE	WIDTH (IN)	HEIGHT (IN)	SHEETING REMARKS	SIGN LEGEND FOR POST LENGTHS AND INSTALLATION DATES SEE ORIGINAL RECORD PLANS	NEW SIGNS "A"	NEW SIGNS "B"	EXISTING SIGNS RETAIN	EXISTING SIGNS SALVAGE FROM	EXISTING SIGNS SALVAGE TO	EXISTING SIGNS REMOVE	EXIST POST RETAIN	EXIST POST REMOVE	NUMBER OF NEW POSTS	SQUARE STEEL (in) 2.00 (LB / FT) 2.16	SQUARE STEEL (in) 2.00 (LB / FT) 2.42	SQUARE STEEL (in) 2.50 (LB / FT) 3.35	TUBULAR STEEL Ø (IN) FOUNDATION	TUBULAR STEEL Ø (IN) 3.00 (LB / FT) 7.60	TUBULAR STEEL Ø (IN) 3.50 (LB / FT) 9.00	TUBULAR STEEL Ø (IN) 4.00 (LB / FT) 10.80	TUBULAR STEEL Ø (IN) 5.00 (LB / FT) 14.60	SIGN FRAME REQUIRED	REMARKS	SIGN DETAIL: DETAIL IN SHS	SIGN DETAIL: DETAIL ON SHEET NUMBER	SIGN DETAIL: DETAIL ON STD SHEET NUMBER
PERU VT 11							"FY"-FLUORESCENT YELLOW "FYG"-FLUORESCENT YELLOW GREEN																			"SHS"-STANDARD HIGHWAY SIGNS			
		F	S3-1	30	30		SCHOOL BUS STOP AHEAD			1																		
WB	3.374	F	W11-7	30	30								1		X												MISSING?			
		F	W11-7	30	30			6.25								1		X										X		
WB	3.298	F	VD-062BRN	72	16		BUSINESS SIGN			1				X																
		F	VD-062AS	72	16		BUSINESS SIGN			1																				
WB	3.203	F	W1-10L	30	30		LEFT CURVE INTERSECTION WARNING						1		X															
WB	3.163	F	D1-1	72	10		DESTINATION BOARD						1		X															
		F	D1-1	72	10		DESTINATION BOARD						~~1~~ 0																	
		F	W1-10L	30	30			6.25								1		X								X		
		F	W16-8	24	8			~~2.00~~ 1.33																			Main St IN UPPER AND LOWER CASE	X		
WB	3.108	F	D1-1	72	12		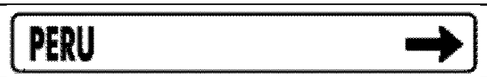	6.00					1			2		X									INSTALL D-BOARDS 300' +/- WEST OF PREVIOUSLY REMOVED		5	
		F	D1-1A	72	12			6.00																					5	
WB	3.080	G	VR-017	30	30								1		X															
		G	VR-017	30	30			5.00								1		X									TH-2, MAIN ST			E-141
WB	3.059	H	R1-1	30	30								1		X															
							SHEET TOTALS	~~31.50~~ 30.83 SF	0.00 SF	3 EA	0 EA	0 EA	6 EA	0 EA	0 EA	5 EA		75 FT											
							TOWN TOTALS	381.1	0.0	16.0	0.0	0.0	73	2.0	0.0	60		900.0											

SIGN SUMMARY SHEET

VERMONT AGENCY OF TRANSPORTATION

PROJECT NAME: Manchester-Springfield
PROJECT NUMBER: STPG SIGN(25)

FILE NAME: Peru VT11.xls
PROJECT MANAGER: N. Avery
DESIGNED BY: A. Gamble
PERU SHEET 7

PLOT DATE: 4/8/2009
DRAWN BY: T. Guazzoni
CHECKED BY: S. Menard