DIR	MILEPOINT	LOCATION CODE (SHEET 2)	MUTCD CODE	WIDTH (IN)	HEIGHT (IN)	SHEETING REMARKS	SIGN LEGEND	NEW SIGNS "A"	NEW SIGNS "B"	EXISTING SIGNS RETAIN	EXISTING SIGNS SALVAGE FROM	EXISTING SIGNS SALVAGE TO	EXISTING SIGNS REMOVE	EXIST POST RETAIN	EXIST POST REMOVE	NUMBER OF NEW POSTS	SQUARE STEEL (in) 2.00 (LB / FT) 2.16	SQUARE STEEL (in) 2.00 (LB / FT) 2.42	SQUARE STEEL (in) 2.50 (LB / FT) 3.35	FOUNDATION	TUBULAR STEEL Ø (IN) 3.00 (LB / FT) 7.60	TUBULAR STEEL Ø (IN) 3.50 (LB / FT) 9.00	TUBULAR STEEL Ø (IN) 4.00 (LB / FT) 10.80	TUBULAR STEEL Ø (IN) 5.00 (LB / FT) 14.60	SIGN FRAME REQUIRED	REMARKS	SIGN DETAIL: DETAIL IN SHS	SIGN DETAIL: DETAIL ON SHEET NUMBER	SIGN DETAIL: DETAIL ON STD SHEET NUMBER
LONDONDERRY VT11							"FY"-FLUORESCENT YELLOW "FYG"-FLUORESCENT YELLOW GREEN																			"SHS"-STANDARD HIGHWAY SIGNS			
WB	0.671	G	VR-017	24	30		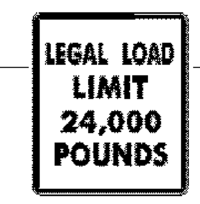						1		X											REILLY ROAD (TH-8); SIGN MISSING			
		G	VR-017	24	30			5.00								1		X											
WB	0.663	H	R1-1	30	30		STOP			X				X												REILLY ROAD (TH-8)			
WB	0.250	F	S1-1YG	36	36		PENTAGONAL SCHOOL SYMBOL			X				X															
							SHEET TOTALS	5.00	0.00	~~0~~ 2	0	0	1	0	0	1		15											
								SF	SF	EA	EA	EA	EA	EA	EA	EA		FT											
							TOWN TOTALS	932.0	0.0	0.0	3.0	3.0	198	0.0	1.0	132		1980.0											

FOR POST LENGTHS AND INSTALLATION DATES SEE ORIGINAL RECORD PLANS

SIGN SUMMARY SHEET

VERMONT AGENCY OF TRANSPORTATION

PROJECT NAME: **Manchester-Springfield VT11**
PROJECT NUMBER: **STPG SIGN(25)**

FILE NAME: **Londonderrv.xls** PLOT DATE: **4/6/2009**
PROJECT MANAGER: **N. Averv** DRAWN BY: **T. Guazzoni**
DESIGNED BY: **D. Crosslev** CHECKED BY: **S. Menard**
LONDONDERRY SHEET 29 SHEET **70** OF **115**