DIR	MILEPOINT	LOCATION CODE (SHEET 2)	MUTCD CODE	WIDTH (IN)	HEIGHT (IN)	SHEETING REMARKS	SIGN LEGEND FOR POST LENGTHS AND INSTALLATION DATES SEE ORIGINAL RECORD PLANS	NEW SIGNS "A"	NEW SIGNS "B"	EXISTING SIGNS RETAIN	EXISTING SIGNS SALVAGE FROM	EXISTING SIGNS SALVAGE TO	EXISTING SIGNS REMOVE	EXIST POST RETAIN	EXIST POST REMOVE	NUMBER OF NEW POSTS	SQUARE STEEL (in) 2.00 (LB / FT) 2.16	SQUARE STEEL (in) 2.00 (LB / FT) 2.42	SQUARE STEEL (in) 2.50 (LB / FT) 3.35	TUBULAR STEEL Ø (IN) FOUNDATION	TUBULAR STEEL Ø (IN) 3.00 (LB / FT) 7.60	TUBULAR STEEL Ø (IN) 3.50 (LB / FT) 9.00	TUBULAR STEEL Ø (IN) 4.00 (LB / FT) 10.80	TUBULAR STEEL Ø (IN) 5.00 (LB / FT) 14.60	SIGN FRAME REQUIRED	REMARKS	SIGN DETAIL DETAIL IN SHS	SIGN DETAIL DETAIL ON SHEET NUMBER	SIGN DETAIL DETAIL ON STD SHEET NUMBER
ANDOVER VT11							"FY"-FLUORESCENT YE "FYG"-FLUORESCENT Y																			"SHS"-STANDARD HIGHWAY SIGNS			
		F	W13-1	24	24	FY		4.00																			X		
		F	VD-700	6	8		MILE MARKER					1														SALVAGE MILE MARKER TO			
WB	1.964	F	S3-1	30	30		SCHOOL BUS STOP AHEAD			1				X															
WB	1.864	G	VR-017	24	30								1		X											MIDDLETOWN ROAD (TH-25)			
		G	VR-017	24	30			5.00								1		X										E-141
WB	1.860	H	R1-1	30	30		STOP			1				X												MIDDLETOWN ROAD (TH-25)			
WB	1.519	F	VW-054R	30	30		HIDDEN DRIVE RIGHT			1				X															
WB	0.927	G	VR-017	24	30		LEGAL LOAD LIMIT 24000 POUNDS			1				X												GATES ROAD (TH-35)			
WB	0.923	H	R1-1	30	30		STOP				~~1~~ 2				X											GATES ROAD (TH-35)			
		G	VD-700	6	8		MILE MARKER				1																		
		H	R1-1	30	30							~~1~~ 2				1		X											
		G	VD-700	6	8							1																	
WB	0.195	F	VW-001	30	30		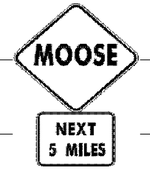						1		X															
		F	W7-3A	24	18								1																
		F	VW-001	30	30			6.25								1		X										6	
							SHEET TOTALS	15.25	0.00	4	~~2~~ 3	~~3~~ 4	3	0	0	3		45										
								SF	SF	EA	EA	EA	EA	EA	EA	EA		FT										
							TOWN TOTALS	69.1	0.0	12.0	8.0	8.0	17	0.0	0.0	15		225.0										

SIGN SUMMARY SHEET

VERMONT AGENCY OF TRANSPORTATION

PROJECT NAME: **Manchester-Springfield VT11**
PROJECT NUMBER: **STPG SIGN(25)**

FILE NAME: **Andover VT11.xls**
PROJECT MANAGER: **N. Avery**
DESIGNED BY: **M. Miller**
ANDOVER SHEET 4

PLOT DATE: **4/6/2009**
DRAWN BY: **T. Guazzoni**
CHECKED BY: **S. Menard**
SHEET **75** OF **115**