DIR	MILEPOINT	LOCATION CODE (SHEET 2)	MUTCD CODE	WIDTH (IN)	HEIGHT (IN)	SHEETING REMARKS	SIGN LEGEND FOR POST LENGTHS AND INSTALLATION DATES SEE ORIGINAL RECORD PLANS	NEW SIGNS "A"	NEW SIGNS "B"	EXISTING SIGNS RETAIN	EXISTING SIGNS SALVAGE FROM	EXISTING SIGNS SALVAGE TO	EXISTING SIGNS REMOVE	EXIST POST RETAIN	EXIST POST REMOVE	NUMBER OF NEW POSTS	SQUARE STEEL (in) 2.00 (LB / FT) 2.16	SQUARE STEEL (in) 2.00 (LB / FT) 2.42	SQUARE STEEL (in) 2.50 (LB / FT) 3.35	TUBULAR STEEL Ø (IN) FOUNDATION	TUBULAR STEEL Ø (IN) 3.00 (LB / FT) 7.60	TUBULAR STEEL Ø (IN) 3.50 (LB / FT) 9.00	TUBULAR STEEL Ø (IN) 4.00 (LB / FT) 10.80	TUBULAR STEEL Ø (IN) 5.00 (LB / FT) 14.60	SIGN FRAME REQUIRED	REMARKS	SIGN DETAIL: DETAIL IN SHS	SIGN DETAIL: DETAIL ON SHEET NUMBER	SIGN DETAIL: DETAIL ON STD SHEET NUMBER
CHESTER VT11							"FY"-FLUORESCENT YELLOW "FYG"-FLUORESCENT YELLOW GREEN																			"SHS"-STANDARD HIGHWAY SIGNS			
EB	0.000	C	VD-024	60	7.5		CHESTER - ANDOVER						1		X														
		C	VD-700	6	8		0110-1407-0000						1																
		C	VD-700	6	8		0110-1401-0368						1																
		C	VD-024	72	10		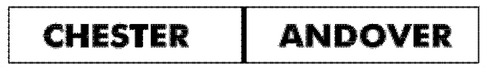	5.00								2		X									4	
		C	VD-700	6	10			0.42																CHESTER MILE MARKER ~ INSTALL ON LEFT POST (UNDER CHESTER)			E-138
		C	VD-700	6	10			0.42																ANDOVER MILE MARKER ~ INSTALL ON RIGHT POST (UNDER ANDOVER)			E-138
EB	0.002	A	W1-5L	30	30			6.25								1		X								INSTALL BETWEEN TOWN LINE SIGN AND UTILITY POLE JUST AHEAD ~ MAINTAIN 10 FT MIN CLEARANCE TO POLE.	X		
		A	W7-3A	24	18			3.00																NEXT 1/2 MILE (PLAQUE)	X		
EB	0.915	A	W1-2R	30	30								1		X														
		A	W1-2R	30	30			6.25								1		X									X		
EB	1.207	A	D1-1	72	12		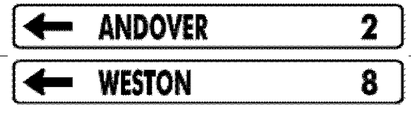	6.00								2		X								INSTALL ASSEMBLY 225 FEET± WEST OF (IN ADVANCE OF) NEXT ASSEMBLY BEING REMOVED.		5	
		A	D1-1	72	12			6.00																				5	
		A	VD-700	6	8		MILE MARKER						~~1~~ X														SALVAGE FROM ASSEMBLY AT MP 1.250			
EB	1.250	A	D1-1	54	7.5		<--- ANDOVER 2						1		X														
		A	D1-1	54	7.5		<--- WESTON 8						~~1~~ 1														THIS SIGN IS MISSING			
							SHEET TOTALS	33.34	0.00	0	0	~~1~~ 0	~~6~~ 5	0	0	6		90										
								SF	SF	EA	EA	EA	EA	EA	EA	EA		FT										
							TOWN TOTALS	795.8	0.0	4.0	2.0	2.0	155	0.0	1.0	134		2010.0										

SIGN SUMMARY SHEET

VERMONT AGENCY OF TRANSPORTATION

PROJECT NAME: **Manchester-Springfield VT11**
PROJECT NUMBER: **STPG SIGN(25)**

FILE NAME: **Chester VT11.xls** PLOT DATE: **4/8/2009**
PROJECT MANAGER: **N. Avery** DRAWN BY: **T. Guazzoni**
DESIGNED BY: **M. Miller** CHECKED BY: **S. Menard**
CHESTER SHEET 1 SHEET **77** OF **115**