DIR	MILEPOINT	LOCATION CODE (SHEET 2)	MUTCD CODE	WIDTH (IN)	HEIGHT (IN)	SHEETING REMARKS	SIGN LEGEND FOR POST LENGTHS AND INSTALLATION DATES SEE ORIGINAL RECORD PLANS	NEW SIGNS "A"	NEW SIGNS "B"	EXISTING SIGNS RETAIN	EXISTING SIGNS SALVAGE FROM	EXISTING SIGNS SALVAGE TO	EXISTING SIGNS REMOVE	EXIST POST RETAIN	EXIST POST REMOVE	NUMBER OF NEW POSTS	SQUARE STEEL (in) 2.00 (LB / FT) 2.16	SQUARE STEEL (in) 2.00 (LB / FT) 2.42	SQUARE STEEL (in) 2.50 (LB / FT) 3.35	TUBULAR STEEL Ø (IN) FOUNDATION	TUBULAR STEEL Ø (IN) 3.00 (LB / FT) 7.60	TUBULAR STEEL Ø (IN) 3.50 (LB / FT) 9.00	TUBULAR STEEL Ø (IN) 4.00 (LB / FT) 10.80	TUBULAR STEEL Ø (IN) 5.00 (LB / FT) 14.60	SIGN FRAME REQUIRED	REMARKS	SIGN DETAIL: DETAIL IN SHS	SIGN DETAIL: DETAIL ON SHEET NUMBER	SIGN DETAIL: DETAIL ON STD SHEET NUMBER
SPRINGFIELD VT 11							"FY"-FLUORESCENT YELLOW "FYG"-FLUORESCENT YELLOW GREEN																			"SHS"-STANDARD HIGHWAY SIGNS			
EB	0.000	C	VD-024	60	7.5								3 ~~1~~		X														
		C	VD-024	72	10		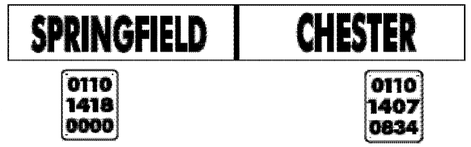	5.00								2		X								4	
		C	VD-700	6	10			0.42																					E-138
		C	VD-700	6	10			0.42																					E-138
EB	0.252	A	W11-7	30	30		EQUESTRIAN						2 ~~1~~		X														
EB	0.431	C	VR-017	24	30						1		1		X											TH-78, PLEASANT VALLEY RD			
		C	VR-017	24	30			5.00				1				1		X											E-141
EB	0.439	D	R1-1	30	30		STOP			1																	TH-78, PLEASANT VALLEY RD			
EB	1.772	C	VR-017	24	30						1		1		X												TH-90, STELLAFANE RD			
		C	VR-017	24	30			5.00				1			1		X											E-141
		C	R2-1	18	24		TOWN'S SPEED LIMIT 25				1	1																	
EB	1.764	D	R1-1	30	30		STOP			1																	TH-90, STELLAFANE RD			
EB	2.345	A	W3-5	36	36		SPEED REDUCTION 40 MPH			1				X															
EB	2.391	A	W2-3ML	30	30		INTERSECTION WARNING				1		1		X												RE-INSTALL EXISTING SIGN ON NEW POST			
		A	W2-3ML	30	30							1				1		X											
SIGN SUMMARY SHEET							SHEET TOTALS	15.84	0.00	3	4 ~~2~~	4 ~~2~~	8 ~~4~~	0	0	5		75										
								SF	SF	EA	EA	EA	EA	EA	EA	EA		FT										
VERMONT AGENCY OF TRANSPORTATION							TOWN TOTALS	411.7	48.0	26.0	12.0	11.0	74	0.0	0.0	72		1080.0										

PROJECT NAME: **Manchester-Springfield VT-11**
PROJECT NUMBER: **STPG SIGN(25)**

FILE NAME: **Springfield VT11.xls** PLOT DATE: **4/7/2009**
PROJECT MANAGER: **N. Avery** DRAWN BY: **J. Kelly**
DESIGNED BY: **J. Kelly** CHECKED BY: **S. Menard**
SPRINGFIELD SHEET 1 SHEET **99** OF **115**