DIRECTION	MILEPOINT	LOCATION CODE (SHEET 2)	SIGN CODE	WIDTH (IN)	HEIGHT (IN)	SHEETING REMARKS	SIGN LEGEND FOR ALL POST LENGTHS AND INSTALLATION DATES SEE ORIGINAL RECORD PLANS	NEW SIGNS "A"	NEW SIGNS "B"	EXISTING SIGNS RETAIN	EXISTING SIGNS SALVAGE FROM	EXISTING SIGNS SALVAGE TO	EXISTING SIGNS REMOVE	EXIST POST RETAIN	EXIST POST REMOVE	NUMBER OF NEW POSTS	SQUARE STEEL (IN) 1.75 (LB / FT) 1.88	SQUARE STEEL (IN) 2.00 (LB / FT) 2.42	SQUARE STEEL (IN) 2.50 (LB / FT) 3.35	TUBULAR STEEL Ø (IN) FOUNDATION	TUBULAR STEEL Ø (IN) 3.00 (LB / FT) 7.60	TUBULAR STEEL Ø (IN) 3.50 (LB / FT) 9.00	TUBULAR STEEL Ø (IN) 4.00 (LB / FT) 10.80	TUBULAR STEEL Ø (IN) 5.00 (LB / FT) 14.60	SIGN FRAME REQUIRED	REMARKS	SIGN DETAIL DETAIL IN SHS	SIGN DETAIL DETAIL ON SHEET NUMBER	SIGN DETAIL DETAIL ON STD SHEET NUMBER
HARTFORD VT 14							FY-FLUORESCENT YELLOW FYG-FLUORESCENT YELLOW GREEN																			"SHS"-STANDARD HIGHWAY SIGNS			
NB	6.040	C	VR-398	24	30		NO PARKING THIS SIDE						1		X														
NB	6.350	A	W3-5	36	36		SPEED REDUCTION SPEED LIMIT 35	9.00		1			1	X													SHOTGUN DAMAGE REDO		
NB	6.400	A	VD-018	30	18								1		X														
		A	VD-018	30	18			3.75								1		X										E-128B
NB	6.460	A	W1-4R	30	30		RIGHT REVERSE CURVE			1				X															
NB	6.483	A	R2-1	24	30		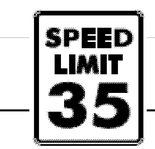						1		X														
		A	R2-1	30	36			7.50								1		X										6
NB	6.620	A	W11-2	30	30								1		X														
		A	W7-3A	24	18								1																
		A	W11-2	30	30	F-Y-G		6.25								1		X										X	
		A	W7-3A	24	18	F-Y-G		3.00																				X	
NB	6.667	A	R2-1	24	30		SPEED LIMIT 35			1				X															
NB	6.858	A	M3-1S	24	12		NORTH			1				X															
		A	M1-5	24	24		VERMONT 14			1																			
NB	6.978	C	VR-017	24	30		LEGAL LOAD LIMIT 24,000 LBS			1				X													HARPER SAVAGE LN TH-35		
							SHEET TOTALS	29.50 ~~20.50~~ SF	0.00 SF	6 EA	0 EA	0 EA	6 ~~5~~ EA	0 EA	0 EA	3 EA	45 FT										
							TOWN TOTALS	130.2 SF	0.0 SF	41.0 EA	13.0 EA	9.0 EA	26 EA	0.0 EA	0.0 EA	26 EA	390.0 FT												

SIGN SUMMARY SHEET

VERMONT AGENCY OF TRANSPORTATION

PROJECT NAME: **Hartford-East Montpelier VT14**
PROJECT NUMBER: **STPG SIGN(21)**

FILE NAME: **Hartford.xls** PLOT DATE: **6/10/2009**
PROJECT MANAGER: **N. Avery** DRAWN BY: **I. Shea**
DESIGNED BY: **D. Crossley** CHECKED BY: **S. Menard**
HARTFORD SHEET 3 SHEET **10** OF **162**