DIRECTION	MILEPOINT	LOCATION CODE (SHEET 2)	SIGN CODE	WIDTH (IN)	HEIGHT (IN)	SHEETING REMARKS	SIGN LEGEND	NEW SIGNS "A"	NEW SIGNS "B"	EXISTING SIGNS RETAIN	EXISTING SIGNS SALVAGE FROM	EXISTING SIGNS SALVAGE TO	EXISTING SIGNS REMOVE	EXIST POST RETAIN	EXIST POST REMOVE	NUMBER OF NEW POSTS	SQUARE STEEL (IN) 1.75 (LB / FT) 1.88	SQUARE STEEL (IN) 2.00 (LB / FT) 2.42	SQUARE STEEL (IN) 2.50 (LB / FT) 3.35	FOUNDATION	TUBULAR STEEL Ø (IN) 3.00 (LB / FT) 7.60	TUBULAR STEEL Ø (IN) 3.50 (LB / FT) 9.00	TUBULAR STEEL Ø (IN) 4.00 (LB / FT) 10.80	TUBULAR STEEL Ø (IN) 5.00 (LB / FT) 14.60	SIGN FRAME REQUIRED	REMARKS	SIGN DETAIL: DETAIL IN SHS	SIGN DETAIL: DETAIL ON SHEET NUMBER	SIGN DETAIL: DETAIL ON STD SHEET NUMBER
SHARON VT14							FY-FLUORESCENT YELLOW FYG-FLUORESCENT YELLOW GREEN																			"SHS"-STANDARD HIGHWAY SIGNS			
		A	D1-1A	72	10								1																
		A	D1-1A	72	12		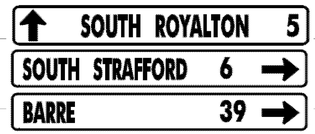	6.00								2		X									5	
		A	D1-1A	72	12			6.00																			5	
		A	D1-1A	72	12			6.00																			5	
NB	4.990	A	M3-1S	24	12								1	X														
		A	M1-5	24	24								1															
		A	M6-3S	21	15								1															
		A	M3-2S	24	12								1															
		A	M1-5	30	24								1															
		A	M6-1S	21	15								1															
		A	M4-5	24	12								1															
		A	M1-1	24	24								1															
		A	M6-1	21	15								1															
		A	M3-1S	24	12			2.00																3B	GREEN ON WHITE SHEETING	X	7	
		A	M1-5	24	24			4.00																				E-136B
							SHEET TOTALS	24.00	0.00	0	0	0	10	0	0	2		30										
								SF	SF	EA	EA	EA	EA	EA	EA	EA		FT										
							TOWN TOTALS	447.0	0.0	11.0	1.0	1.0	93	0.0	0.0	64		960.0										

SIGN SUMMARY SHEET

VERMONT AGENCY OF TRANSPORTATION

PROJECT NAME: **Hartford-East Montpelier VT14**
PROJECT NUMBER: **STPG SIGN(21)**

FILE NAME: **Sharon.xls** PLOT DATE: **6/10/2009**
PROJECT MANAGER: **N. Avery** DRAWN BY: **T. Guazzoni**
DESIGNED BY: **D. Crossley** CHECKED BY: **S. Menard**
SHARON SHEET 4 SHEET **19** OF **162**