DIRECTION	MILEPOINT	LOCATION CODE (SHEET 2)	SIGN CODE	WIDTH (IN)	HEIGHT (IN)	SHEETING REMARKS	SIGN LEGEND FOR ALL POST LENGTHS AND INSTALLATION DATES SEE ORIGINAL RECORD PLANS	NEW SIGNS "A"	NEW SIGNS "B"	EXISTING SIGNS RETAIN	EXISTING SIGNS SALVAGE FROM	EXISTING SIGNS SALVAGE TO	EXISTING SIGNS REMOVE	EXIST POST RETAIN	EXIST POST REMOVE	NUMBER OF NEW POSTS	SQUARE STEEL (IN) 1.75 (LB / FT) 1.88	SQUARE STEEL (IN) 2.00 (LB / FT) 2.42	SQUARE STEEL (IN) 2.50 (LB / FT) 3.35	TUBULAR STEEL Ø (IN) FOUNDATION	TUBULAR STEEL Ø (IN) 3.00 (LB / FT) 7.60	TUBULAR STEEL Ø (IN) 3.50 (LB / FT) 9.00	TUBULAR STEEL Ø (IN) 4.00 (LB / FT) 10.80	TUBULAR STEEL Ø (IN) 5.00 (LB / FT) 14.60	SIGN FRAME REQUIRED	REMARKS	SIGN DETAIL: DETAIL IN SHS	SIGN DETAIL: DETAIL ON SHEET NUMBER	SIGN DETAIL: DETAIL ON STD SHEET NUMBER
ROYALTON VT 14							FY-FLUORESCENT YELLOW FYG-FLUORESCENT YELLOW GREEN																			"SHS"-STANDARD HIGHWAY SIGNS			
								0.84																		2 MM PLAQUES @ 0.42 SF EA.			
NB	0.000	C	VD-024	60	7.5		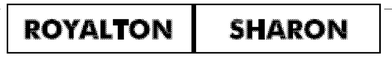						1		X														
		C	VD-024	72	10			5.00								2		X										4
NB	0.600	A	S3-1	30	30								1		X														
		A	S3-1	30	30			6.25					1			1		X								PAINTBALL DAMAGE	X	
NB	0.760	A	W1-2L	30	30								0 ~~1~~		~~X~~														
		A	W1-2L	30	30			6.25								1		X								INSTALL 150' +/- NORTH OF ORIGINAL LOCATION	X	
NB	0.900	A	R2-5A	24	30								0 ~~1~~		~~X~~														
		A	W3-5	36	36			9.00								2		X									X	
NB	1.130	A	R2-1	24	30								1		X														
		A	R2-1	30	36			7.50								1		X										6
NB	1.137	A	VD-062B	72	16		BUSINESS SIGN			1				X														
NB	1.200	A	W2-2R	30	30		SIDE ROAD RIGHT						1		X														
		A	W13-1	18	18		40 MPH PLAQUE						1																
NB	1.260	A	VW-060	30	30		HIDDEN DRIVES						1		X														
SIGN SUMMARY SHEET							SHEET TOTALS	~~34.00~~ 41.09 SF	0.00 SF	1 EA	0 EA	0 EA	~~8~~ 7 EA	0 EA	0 EA	7 EA	105 FT												
VERMONT AGENCY OF TRANSPORTATION							TOWN TOTALS	973.5	0.0	62.0	9.0	9.0	190	0.0	0.0	152	2280.0											

PROJECT NAME: East Montpelier-Hartford VT14
PROJECT NUMBER: STPG SIGN(21)

FILE NAME: Royalton.xls
PROJECT MANAGER: N. Avery
DESIGNED BY: D. Crossley
ROYALTON SHEET 1

PLOT DATE: 6/10/2009
DRAWN BY: T. Guazzoni
CHECKED BY: S. Menard
SHEET 30 OF 162