DIRECTION	MILEPOINT	LOCATION CODE (SHEET 2)	SIGN CODE	WIDTH (IN)	HEIGHT (IN)	SHEETING REMARKS	SIGN LEGEND FOR ALL POST LENGTHS AND INSTALLATION DATES SEE ORIGINAL RECORD PLANS	NEW SIGNS "A"	NEW SIGNS "B"	EXISTING SIGNS RETAIN	EXISTING SIGNS SALVAGE FROM	EXISTING SIGNS SALVAGE TO	EXISTING SIGNS REMOVE	EXIST POST RETAIN	EXIST POST REMOVE	NUMBER OF NEW POSTS	SQUARE STEEL (IN) 1.75 (LB / FT) 1.88	SQUARE STEEL (IN) 2.00 (LB / FT) 2.42	SQUARE STEEL (IN) 2.50 (LB / FT) 3.35	TUBULAR STEEL Ø (IN) FOUNDATION	TUBULAR STEEL Ø (IN) 3.00 (LB / FT) 7.60	TUBULAR STEEL Ø (IN) 3.50 (LB / FT) 9.00	TUBULAR STEEL Ø (IN) 4.00 (LB / FT) 10.80	TUBULAR STEEL Ø (IN) 5.00 (LB / FT) 14.60	SIGN FRAME REQUIRED	REMARKS	SIGN DETAIL DETAIL IN SHS	SIGN DETAIL DETAIL ON SHEET NUMBER	SIGN DETAIL DETAIL ON STD SHEET NUMBER
ROYALTON VT 14							FY-FLUORESCENT YELLOW FYG-FLUORESCENT YELLOW GREEN																				"SHS"-STANDARD HIGHWAY SIGNS			
		A	M1-5	30	24		VERMONT 110			1																		
		A	M6-1S	21	15		RIGHT ---->			1																		
NB	2.345	A	W11-2YG	30	30		PEDESTRIAN			1				X														
		A	W16-7YG	30	30		DIAGONAL ARROW			1																		
NB	2.351	A	M3-1S	24	12		NORTH				1				X												SALVAGE TO 2.360 NB		
		A	M1-5	24	24		VERMONT 14				1																SALVAGE TO 2.360 NB		
NB	2.360	A	M3-1S	24	12		NORTH					1				1		X									INSTALL SIGNS 50' +/- NORTH OF ORIGINAL LOCATION SALVAGED FROM 2.351 NB		
		A	M1-5	24	24		VERMONT 14					1															INSTALL SIGNS 50' +/- NORTH OF ORIGINAL LOCATION SALVAGED FROM 2.351 NB		
NB	2.410	A	R2-1	24	30								1		X														
		A	R2-1	24	30			5.00								1		X										X	
NB	2.477	A	D2-1	72	10								1	X															
		A	D2-1	72	12		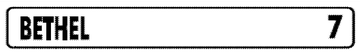	6.00 6.00					1			2										REDO PAINTBALL DAMAGE		5
NB	2.590	A	R2-1	24	30		SPEED LIMIT 50			1				X														
NB	2.733	A	W1-10L	30	30		MODIFIED LEFT CURVE	6.25		1			1	X													REDO SHOTGUN DAMAGE		
NB	2.800	C	VR-017	24	30		LEGAL LOAD LIMIT 24,000 LBS			~~0~~ 1	1	1		X		1											HAPPY HOLLOW RD TH-7		
							SHEET TOTALS	~~23.25~~ 11.00	0.00	~~6~~ 7	~~3~~ 2	~~3~~ 2	~~4~~ 2	0	0	~~5~~ 2		30									
								SF	SF	EA	EA	EA	EA	EA	EA	EA		FT									
							TOWN TOTALS	973.5	0.0	62.0	9.0	9.0	190	0.0	0.0	152		2280.0									

SIGN SUMMARY SHEET

VERMONT AGENCY OF TRANSPORTATION

PROJECT NAME: **East Montpelier-Hartford VT14**
PROJECT NUMBER: **STPG SIGN(21)**

FILE NAME: **Royalton.xls** PLOT DATE: **6/10/2009**
PROJECT MANAGER: **N. Avery** DRAWN BY: **T. Guazzoni**
DESIGNED BY: **D. Crossley** CHECKED BY: **S. Menard**
ROYALTON SHEET 4 SHEET **33** OF **162**