DIRECTION	MILEPOINT	LOCATION CODE (SHEET 2)	SIGN CODE	WIDTH (IN)	HEIGHT (IN)	SHEETING REMARKS	SIGN LEGEND FOR ALL POST LENGTHS AND INSTALLATION DATES SEE ORIGINAL RECORD PLANS	NEW SIGNS "A"	NEW SIGNS "B"	EXISTING SIGNS RETAIN	EXISTING SIGNS SALVAGE FROM	EXISTING SIGNS SALVAGE TO	EXISTING SIGNS REMOVE	EXIST POST RETAIN	EXIST POST REMOVE	NUMBER OF NEW POSTS	SQUARE STEEL (IN) 1.75 (LB / FT) 1.88	SQUARE STEEL (IN) 2.00 (LB / FT) 2.42	SQUARE STEEL (IN) 2.50 (LB / FT) 3.35	TUBULAR STEEL Ø (IN) FOUNDATION	TUBULAR STEEL Ø (IN) 3.00 (LB / FT) 7.60	TUBULAR STEEL Ø (IN) 3.50 (LB / FT) 9.00	TUBULAR STEEL Ø (IN) 4.00 (LB / FT) 10.80	TUBULAR STEEL Ø (IN) 5.00 (LB / FT) 14.60	SIGN FRAME REQUIRED	REMARKS	SIGN DETAIL: DETAIL IN SHS	SIGN DETAIL: DETAIL ON SHEET NUMBER	SIGN DETAIL: DETAIL ON STD SHEET NUMBER
RANDOLPH VT 14							FY-FLUORESCENT YELLOW FYG-FLUORESCENT YELLOW GREEN																			"SHS"-STANDARD HIGHWAY SIGNS			
		A	OM-3R	12	36			3.00								1		X									X		
NB	1.280	A	VD-018	30	18								~~1~~ 2		X															
		A	VD-018	30	18			3.75								1		X											E-128B
NB	1.390	A	W1-2L	30	30		LEFT CURVE						1		X															
		A	W13-1	18	18		35 MPH PLAQUE						1																	
NB	1.450	A	W1-2L	30	30			6.25								1		X									INSTALL 300' +/- NORTH OF ORIGINAL SIGN LOCATION	X		
		A	W13-1	18	18			2.25																				X		
NB	1.480	A	W1-8L	18	24		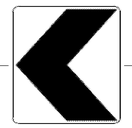						1		X															
		A	W1-8L	24	30			5.00								1		X										X		
NB	1.480	B	W1-8R	18	24								1		X															
		B	W1-8R	24	30			5.00								1		X										X		
NB	1.490	A	W1-8L	18	24								1		X															
		A	W1-8L	24	30			5.00								1		X										X		
NB	1.490	B	W1-8R	18	24		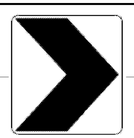						1		X															
		B	W1-8R	24	30			5.00								1		X										X		
SIGN SUMMARY SHEET VERMONT AGENCY OF TRANSPORTATION							SHEET TOTALS	35.25 SF	0.00 SF	0 EA	0 EA	0 EA	~~8~~ 7 EA	0 EA	0 EA	7 EA	105 FT												
							TOWN TOTALS	771.4	0.0	19.0	5.0	5.0	155	0.0	0.0	130	1950.0											

PROJECT NAME: Hartford-East Montpelier VT14
PROJECT NUMBER: STPG SIGN(25)

FILE NAME: Randolph.xls
PROJECT MANAGER: N. Avery
DESIGNED BY: D. Crossley
RANDOLPH SHEET 2

PLOT DATE: 6/18/2009
DRAWN BY: I. Shea
CHECKED BY: S. Menard
SHEET 65 OF 162