DIRECTION	MILEPOINT	LOCATION CODE (SHEET 2)	SIGN CODE	WIDTH (IN)	HEIGHT (IN)	SHEETING REMARKS	SIGN LEGEND	NEW SIGNS "A"	NEW SIGNS "B"	EXISTING SIGNS RETAIN	EXISTING SIGNS SALVAGE FROM	EXISTING SIGNS SALVAGE TO	EXISTING SIGNS REMOVE	EXIST POST RETAIN	EXIST POST REMOVE	NUMBER OF NEW POSTS	SQUARE STEEL (IN) 1.75 (LB / FT) 1.88	SQUARE STEEL (IN) 2.00 (LB / FT) 2.42	SQUARE STEEL (IN) 2.50 (LB / FT) 3.35	TUBULAR STEEL Ø (IN) FOUNDATION	TUBULAR STEEL Ø (IN) 3.00 (LB / FT) 7.60	TUBULAR STEEL Ø (IN) 3.50 (LB / FT) 9.00	TUBULAR STEEL Ø (IN) 4.00 (LB / FT) 10.80	TUBULAR STEEL Ø (IN) 5.00 (LB / FT) 14.60	SIGN FRAME REQUIRED	REMARKS	SIGN DETAIL: DETAIL IN SHS	SIGN DETAIL: DETAIL ON SHEET NUMBER	SIGN DETAIL: DETAIL ON STD SHEET NUMBER
WILLIAMSTOWN VT 14							FY-FLUORESCENT YELLOW FYG-FLUORESCENT YELLOW GREEN																			"SHS"-STANDARD HIGHWAY SIGNS			
NB	5.650	C	VR-023B	30	30		$500 FINE/TRASH						1		X											GRAVEL PULLOUT			
NB	6.090	C	VR-017	24	30		LEGAL LOAD LIMIT 24000 LBS			1				X												TH-89, HULBERT RD			
NB	6.100	D	R1-1	30	30		STOP			1				X												TH-89, HULBERT RD			
NB	6.410	C	VR-017	24	30		LEGAL LOAD LIMIT 24000 LBS			1				X												TH-75, FARNHAM RD			
NB	6.420	D	R1-1	30	30		STOP			1				X												TH-75, FARNHAM RD			
NB	6.550	A	W11-10	30	30		TRUCK ENTERING SYMBOL			1				X												ASSEMBLY HAS SOLAR FLASHING BEACON ATTACHED			
		A	S4-4M	24	10		WHEN FLASHING (YELLOW BKGRND)			1																			
NB	6.670	A	R2-5A	24	30		REDUCED SPEED AHEAD 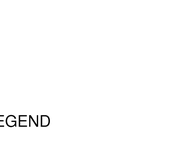						1		X															
NB	6.695	A	W3-5	36	36			9.00								2		X								INSTALL 20 FT BEYOND PIKE DRIVEWAY, 10 FT SOUTH OF UTILITY POLE	X		
NB	6.725	A	W1-2MbR	30	30			6.25								2		X								INSTALL 200 FT +/- NORTH OF SPEED REDUCTION WARNING SIGN.		6	
		A	S3-1	30	30			6.25																			X		
NB	6.740	A	S3-1	30	30		SCHOOL BUS STOP AHEAD						1		X															
NB	6.750	A	W2-2R	30	30		SIDE ROAD RIGHT						1		X															
NB	6.805	A	R2-1	24	30								1		X															
		A	R2-1	24	30			5.00								1		X									X		
							SHEET TOTALS	26.50 SF	0.00 SF	6 EA	0 EA	0 EA	5 EA	0 EA	0 EA	5 EA		75 FT											
							TOWN TOTALS	501.1	0.0	67.0	0.0	0.0	94	0.0	0.0	109		1635.0											

SIGN SUMMARY SHEET

VERMONT AGENCY OF TRANSPORTATION

PROJECT NAME: **Hartford-East Montpelier VT14**
PROJECT NUMBER: **SIGN STPG(21)**

FILE NAME: **Williamstown.xls** PLOT DATE: **6/18/2009**
PROJECT MANAGER: **N. Avery** DRAWN BY: **T. Guazzoni**
DESIGNED BY: **A. Gamble** CHECKED BY: **S. Menard**
WILLIAMSTOWN SHEET 8 SHEET **104** OF **162**