DIRECTION	MILEPOINT	LOCATION CODE (SHEET 2)	SIGN CODE	WIDTH (IN)	HEIGHT (IN)	SHEETING REMARKS	SIGN LEGEND FOR ALL POST LENGTHS AND INSTALLATION DATES SEE ORIGINAL RECORD PLANS	NEW SIGNS "A"	NEW SIGNS "B"	EXISTING SIGNS RETAIN	EXISTING SIGNS SALVAGE FROM	EXISTING SIGNS SALVAGE TO	EXISTING SIGNS REMOVE	EXIST POST RETAIN	EXIST POST REMOVE	NUMBER OF NEW POSTS	SQUARE STEEL (IN) 1.75 (LB / FT) 1.88	SQUARE STEEL (IN) 2.00 (LB / FT) 2.42	SQUARE STEEL (IN) 2.50 (LB / FT) 3.35	TUBULAR STEEL Ø (IN) FOUNDATION	TUBULAR STEEL Ø (IN) 3.00 (LB / FT) 7.60	TUBULAR STEEL Ø (IN) 3.50 (LB / FT) 9.00	TUBULAR STEEL Ø (IN) 4.00 (LB / FT) 10.80	TUBULAR STEEL Ø (IN) 5.00 (LB / FT) 14.60	SIGN FRAME REQUIRED	REMARKS	SIGN DETAIL: DETAIL IN SHS	SIGN DETAIL: DETAIL ON SHEET NUMBER	SIGN DETAIL: DETAIL ON STD SHEET NUMBER
BARRE TOWN VT 14							FY-FLUORESCENT YELLOW FYG-FLUORESCENT YELLOW GREEN																			"SHS"-STANDARD HIGHWAY SIGNS			
		A	M1-5	24	24			4.00																					E-136B
		A	M6-3	21	15			2.19																		GREEN ON WHITE SHEETING	X		
NB	1.660	L	R6-1R	36	12		ONE WAY (FACING EAST IN MEDIAN)			1				X															
NB	1.670	K	R4-7	24	30		KEEP RIGHT SYMBOL (MEDIAN FACING SB)			1				X															
		K	OM1-1	12	12		YELLOW CLUSTER (MEDIAN FACING SB)			1																			
NB	1.680	C	VR-017	24	30		LEGAL LOAD LIMIT 24000 LBS			1				X												TH-4, MIDDLE RD			
NB	1.685	M	R10-12	24	30		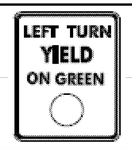						1															
		M	R10-12	24	30			5.00																		INSTALL ON SPAN WIRE NEXT TO LEFT TURN SIGNAL	X		
NB	1.687	C	R4-7	24	30								~~1~~ 2		X											REMOVED MM PLAQUE			
		C	OM1-1	12	12								1																
		C	R4-7	24	30			5.00			~~4~~	~~4~~				1		X							INSTALL ON MIDDLE RD MEDIAN FACING EB (VT 63)	X		
		C	OM1-1	12	12			1.00								~~1~~									4 R&S DUE TO POST DAMAGE	X		
NB	1.705	A	M3-1	24	12		NORTH						1		X														
		A	M1-5	24	24		VT 14						1																
		A	M4-5	24	12		TO						1																
							SHEET TOTALS	17.19 SF	0.00 SF	4 EA	~~4~~ 0 EA	~~4~~ 0 EA	~~7~~ 6 EA	0 EA	0 EA	~~2~~ 1 EA	15 FT												
							TOWN TOTALS	583.8	0.0	48.0	9.0	9.0	115	0.0	0.0	89	1335.0												

SIGN SUMMARY SHEET

VERMONT AGENCY OF TRANSPORTATION

PROJECT NAME: **Hartford-East Montpelier VT14**
PROJECT NUMBER: **STPG SIGN(21)**

FILE NAME: **Barre Town.xls** PLOT DATE: **6/18/2009**
PROJECT MANAGER: **N. Averv** DRAWN BY: **T. Guazzoni**
DESIGNED BY: **A. Gamble** CHECKED BY: **S. Menard**
BARRE TOWN SHEET 5 SHEET **119** OF **162**