DIRECTION	MILEPOINT	LOCATION CODE (SHEET 2)	SIGN CODE	WIDTH (IN)	HEIGHT (IN)	SHEETING REMARKS	SIGN LEGEND FOR ALL POST LENGTHS AND INSTALLATION DATES SEE ORIGINAL RECORD PLANS	NEW SIGNS "A"	NEW SIGNS "B"	EXISTING SIGNS RETAIN	EXISTING SIGNS SALVAGE FROM	EXISTING SIGNS SALVAGE TO	EXISTING SIGNS REMOVE	EXIST POST RETAIN	EXIST POST REMOVE	NUMBER OF NEW POSTS	SQUARE STEEL (IN) 1.75 (LB / FT) 1.88	SQUARE STEEL (IN) 2.00 (LB / FT) 2.42	SQUARE STEEL (IN) 2.50 (LB / FT) 3.35	FOUNDATION	TUBULAR STEEL Ø (IN) 3.00 (LB / FT) 7.60	TUBULAR STEEL Ø (IN) 3.50 (LB / FT) 9.00	TUBULAR STEEL Ø (IN) 4.00 (LB / FT) 10.80	TUBULAR STEEL Ø (IN) 5.00 (LB / FT) 14.60	SIGN FRAME REQUIRED	REMARKS	SIGN DETAIL DETAIL IN SHS	SIGN DETAIL DETAIL ON SHEET NUMBER	SIGN DETAIL DETAIL ON STD SHEET NUMBER
BARRE TOWN VT 14							FY-FLUORESCENT YELLOW FYG-FLUORESCENT YELLOW GREEN																			"SHS"-STANDARD HIGHWAY SIGNS			
NB	2.020	A	R2-1	24	30								1		X													
		A	R2-1	24	30			5.00								1		X								X		
NB	2.025	C	VR-017	24	24								0 ~~1~~		X													
		C	VR-017	24	24			5.00								1		X							TH-111, CHRISTIE ST			E-141
NB	2.030	D	R1-1	24	24						2		1		X													
		D	R1-1	30	30			6.25				2				1		X							TH-111, CHRISTIE ST	X		
NB	2.075	A	VD-062C	74.75	16		BUSINESS SIGN			1				X														
		A	VD-062B(	74.75	16		BUSINESS SIGN			1																		
NB	2.200	A	R2-5A	24	30		REDUCED SPEED AHEAD						1		X													
		A	W3-5	36	36			9.00								2		X								X		
NB	2.240	A	VD-018	30	18		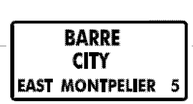						1		X													
		A	VD-018	30	18			3.75								1		X										
NB	2.300	A	VR-038	24	18								1		X													
		A	R2-1	24	30								1															
		A	N/A				UNLESS OTHERWISE POSTED IN CITY LIMITS				1																	
							SHEET TOTALS	29.00	0.00	2	3 ~~1~~	2 ~~0~~	6 ~~7~~	0	0	6		90										
								SF	SF	EA	EA	EA	EA	EA	EA	EA		FT										
							TOWN TOTALS	583.8	0.0	48.0	9.0	9.0	115	0.0	0.0	89		1335.0										

SIGN SUMMARY SHEET

VERMONT AGENCY OF TRANSPORTATION

PROJECT NAME: Hartford-East Montpelier VT14
PROJECT NUMBER: STPG SIGN(21)

FILE NAME: Barre Town.xls
PROJECT MANAGER: N. Avery
DESIGNED BY: A. Gamble
BARRE TOWN SHEET 9

PLOT DATE: 6/18/2009
DRAWN BY: T. Guazzoni
CHECKED BY: S. Menard
SHEET 123 OF 162