DIRECTION	MILEPOINT	LOCATION CODE (SHEET 2)	SIGN CODE	WIDTH (IN)	HEIGHT (IN)	SHEETING REMARKS	SIGN LEGEND FOR ALL POST LENGTHS AND INSTALLATION DATES SEE ORIGINAL RECORD PLANS	NEW SIGNS "A"	NEW SIGNS "B"	EXISTING SIGNS RETAIN	EXISTING SIGNS SALVAGE FROM	EXISTING SIGNS SALVAGE TO	EXISTING SIGNS REMOVE	EXIST POST RETAIN	EXIST POST REMOVE	NUMBER OF NEW POSTS	SQUARE STEEL (IN) (LB / FT) 1.75 / 1.88	SQUARE STEEL (IN) (LB / FT) 2.00 / 2.42	SQUARE STEEL (IN) (LB / FT) 2.50 / 3.35	TUBULAR STEEL Ø (IN) FOUNDATION	TUBULAR STEEL Ø (IN) (LB / FT) 3.00 / 7.60	TUBULAR STEEL Ø (IN) (LB / FT) 3.50 / 9.00	TUBULAR STEEL Ø (IN) (LB / FT) 4.00 / 10.80	TUBULAR STEEL Ø (IN) (LB / FT) 5.00 / 14.60	SIGN FRAME REQUIRED	REMARKS	SIGN DETAIL: DETAIL IN SHS	SIGN DETAIL: DETAIL ON SHEET NUMBER	SIGN DETAIL: DETAIL ON STD SHEET NUMBER
BARRE TOWN VT 14							FY-FLUORESCENT YELLOW FYG-FLUORESCENT YELLOW GREEN																			"SHS"-STANDARD HIGHWAY SIGNS			
		F	VR-039	24	18			3.00								1		X										E-141
		F	R2-1	24	30			5.00																		X		
SB	2.170	F	VD-018	30	18								1		X													
		F	VD-018	30	18			3.75								1		X										E-128B
SB	2.120	F	W2-1	36	36		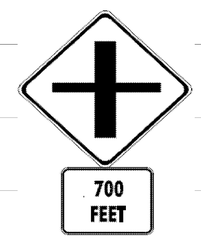						1	X												ASSEMBLY HAS FLASHING BEACONS. RETAIN POSTS AND BEACONS.		
		F	W16-2	24	18								1															
		F	W2-1Mb	36	36	FY		9.00																			6	
		F	W16-2	24	18	FY		3.00																			X	
SB	2.080	F	R2-1	24	30								1		X													
		F	R2-1	24	30			5.00								1		X								X		
SB	2.060	F	W11-2	30	30		PEDESTRIAN						1		X													
SB	2.050	F	W11-2	30	30	FYG		6.25								1		X								INSTALL 50 FT +/- SOUTH OF EXISTING (TO BE REMOVED)	X		
SB	1.980	G	VR-017	24	24						1		1		X										TH-7, BRIDGE ST			
		G	N/A				TOWN PARKING REGULATION SIGN				1																	
		G	VR-017	24	30			5.00								1		X										E-141
							SHEET TOTALS	40.00	0.00	0	~~1~~ 2	0	6	0	0	5		75										
								SF	SF	EA	EA	EA	EA	EA	EA	EA		FT										
							TOWN TOTALS	583.8	0.0	48.0	9.0	9.0	115	0.0	0.0	89		1335.0										

SIGN SUMMARY SHEET

VERMONT AGENCY OF TRANSPORTATION

PROJECT NAME: Hartford-East Montpelier VT14
PROJECT NUMBER: STPG SIGN(21)

FILE NAME: Barre Town.xls
PROJECT MANAGER: N. Avery
DESIGNED BY: A. Gamble
BARRE TOWN SHEET 16

PLOT DATE: 6/18/2009
DRAWN BY: T. Guazzoni
CHECKED BY: S. Menard
SHEET 130 OF 162