DIRECTION	MILEPOINT	LOCATION CODE (SHEET 2)	SIGN CODE	WIDTH (IN)	HEIGHT (IN)	SHEETING REMARKS	SIGN LEGEND FOR ALL POST LENGTHS AND INSTALLATION DATES SEE ORIGINAL RECORD PLANS	NEW SIGNS "A"	NEW SIGNS "B"	EXISTING SIGNS RETAIN	EXISTING SIGNS SALVAGE FROM	EXISTING SIGNS SALVAGE TO	EXISTING SIGNS REMOVE	EXIST POST RETAIN	EXIST POST REMOVE	NUMBER OF NEW POSTS	SQUARE STEEL (IN) 1.75 (LB / FT) 1.88	SQUARE STEEL (IN) 2.00 (LB / FT) 2.42	SQUARE STEEL (IN) 2.50 (LB / FT) 3.35	FOUNDATION	TUBULAR STEEL Ø (IN) 3.00 (LB / FT) 7.60	TUBULAR STEEL Ø (IN) 3.50 (LB / FT) 9.00	TUBULAR STEEL Ø (IN) 4.00 (LB / FT) 10.80	TUBULAR STEEL Ø (IN) 5.00 (LB / FT) 14.60	SIGN FRAME REQUIRED	REMARKS	SIGN DETAIL DETAIL IN SHS	SIGN DETAIL DETAIL ON SHEET NUMBER	SIGN DETAIL DETAIL ON STD SHEET NUMBER
BARRE TOWN			**VT 14**				FY-FLUORESCENT YELLOW FYG-FLUORESCENT YELLOW GREEN																			"SHS"-STANDARD HIGHWAY SIGNS			
SB	1.735	F	D1-1A	54	7.5								1		X														
		F	D1-1A	54	7.5								1																
		F	D1-1A	72	12			6.00								2		X									5	
		F	D1-1A	72	12			6.00																		5	
SB	1.715	F	VR922L	36	30								1		X														
		F	VR922L	36	30		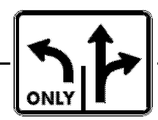	7.50								~~2~~ 1		X									E-145A
SB	1.700	F	M3-3	24	12								1		X														
		F	M1-5	24	24								1																
		F	M6-3	21	15								1																
		F	M3-4	24	12								1																
		F	M1-5	24	24								1																
		F	M6-1	21	15								1																
		F	M4-5	24	12								1																
		F	M1-1	24	24								1																
		F	M6-1	21	15								1																
							SHEET TOTALS	19.50	0.00	0	0	0	12	0	0	~~4~~ 3	60											
								SF	SF	EA	EA	EA	EA	EA	EA	EA	FT											
							TOWN TOTALS	583.8	0.0	48.0	9.0	9.0	115	0.0	0.0	89	1335.0											

SIGN SUMMARY SHEET

VERMONT AGENCY OF TRANSPORTATION

PROJECT NAME: Hartford-East Montpelier VT14
PROJECT NUMBER: STPG SIGN(21)

FILE NAME: Barre Town.xls
PROJECT MANAGER: N. Avery
DESIGNED BY: A. Gamble
BARRE TOWN SHEET 19

PLOT DATE: 6/18/2009
DRAWN BY: T. Guazzoni
CHECKED BY: S. Menard