DIRECTION	MILEPOINT	LOCATION CODE (SHEET 2)	SIGN CODE	WIDTH (IN)	HEIGHT (IN)	SHEETING REMARKS	SIGN LEGEND FOR ALL POST LENGTHS AND INSTALLATION DATES SEE ORIGINAL RECORD PLANS	NEW SIGNS "A"	NEW SIGNS "B"	EXISTING SIGNS RETAIN	EXISTING SIGNS SALVAGE FROM	EXISTING SIGNS SALVAGE TO	EXISTING SIGNS REMOVE	EXIST POST RETAIN	EXIST POST REMOVE	NUMBER OF NEW POSTS	SQUARE STEEL (IN) 1.75 (LB / FT) 1.88	SQUARE STEEL (IN) 2.00 (LB / FT) 2.42	SQUARE STEEL (IN) 2.50 (LB / FT) 3.35	FOUNDATION	TUBULAR STEEL Ø (IN) 3.00 (LB / FT) 7.60	TUBULAR STEEL Ø (IN) 3.50 (LB / FT) 9.00	TUBULAR STEEL Ø (IN) 4.00 (LB / FT) 10.80	TUBULAR STEEL Ø (IN) 5.00 (LB / FT) 14.60	SIGN FRAME REQUIRED	REMARKS	SIGN DETAIL: DETAIL IN SHS	SIGN DETAIL: DETAIL ON SHEET NUMBER	SIGN DETAIL: DETAIL ON STD SHEET NUMBER
E MONTPELIER VT 14							FY-FLUORESCENT YELLOW FYG-FLUORESCENT YELLOW GREEN																			"SHS"-STANDARD HIGHWAY SIGNS			
		F	M1-5	24	24								1																
		F	M6-3	21	15								1																
		F	M3-4	24	12								1																
		F	M1-4	24	24								1																
		F	M6-3	21	15								1																
		F	M3-2	24	12			2.00								2			X						#3A		X	7	
		F	M1-4	24	24			4.00																			X		
		F	M6-1	21	15			2.19																			X		
		F	M3-3	24	12		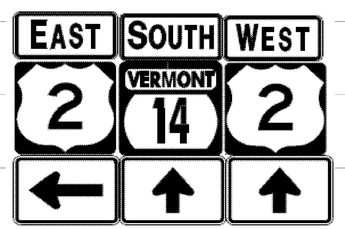	2.00																		GREEN ON WHITE SHEETING	X		
		F	M1-5	24	24			4.00																					E-136B
		F	M6-3	21	15			2.19																		GREEN ON WHITE SHEETING	X		
		F	M3-4	24	12			2.00																			X		
		F	M1-4	24	24			4.00																			X		
		F	M6-3	21	15			2.19																			X		
SB	2.495	F	D1-2R	72	20								~~1~~ 2		X											REMOVED MM PLAQUE			
							SHEET TOTALS	24.57	0.00	0	0	0	~~6~~ 7	0	0	2			30										
								SF	SF	EA	EA	EA	EA	EA	EA	EA			FT										
							TOWN TOTALS	803.2	0.0	27.0	3.0	3.0	149	0.0	0.0	132			1980.0										

SIGN SUMMARY SHEET

VERMONT AGENCY OF TRANSPORTATION

PROJECT NAME: Hartford-East Montpelier VT14
PROJECT NUMBER: STPG SIGN(21)

FILE NAME: East Montpelier.xls
PROJECT MANAGER: N. Avery
DESIGNED BY: M. Miller
EAST MONTPELIER SHEET 20

PLOT DATE: 6/18/2009
DRAWN BY: T. Guazzoni
CHECKED BY: S. Menard