DIRECTION	MILEPOINT	LOCATION CODE (SHEET 2)	SIGN CODE	WIDTH (IN)	HEIGHT (IN)	SHEETING REMARKS	SIGN LEGEND	NEW SIGNS "A"	NEW SIGNS "B"	EXISTING SIGNS RETAIN	EXISTING SIGNS SALVAGE FROM	EXISTING SIGNS SALVAGE TO	EXISTING SIGNS REMOVE	EXIST POST RETAIN	EXIST POST REMOVE	NUMBER OF NEW POSTS	SQUARE STEEL (IN) 1.75 (LB / FT) 1.88	SQUARE STEEL (IN) 2.00 (LB / FT) 2.42	SQUARE STEEL (IN) 2.50 (LB / FT) 3.35	FOUNDATION	TUBULAR STEEL Ø (IN) 3.00 (LB / FT) 7.60	TUBULAR STEEL Ø (IN) 3.50 (LB / FT) 9.00	TUBULAR STEEL Ø (IN) 4.00 (LB / FT) 10.80	TUBULAR STEEL Ø (IN) 5.00 (LB / FT) 14.60	SIGN FRAME REQUIRED	REMARKS	SIGN DETAIL: DETAIL IN SHS	SIGN DETAIL: DETAIL ON SHEET NUMBER	SIGN DETAIL: DETAIL ON STD SHEET NUMBER
TUNBRIDGE VT 110							FY-FLUORESCENT YELLOW FYG-FLUORESCENT YELLOW GREEN																			"SHS"-STANDARD HIGHWAY SIGNS			
NB	0.000	C	VD-024	60	7.5								1		X														
		C	VD-025	60	7.5								1																
		C	VD-024	72	10		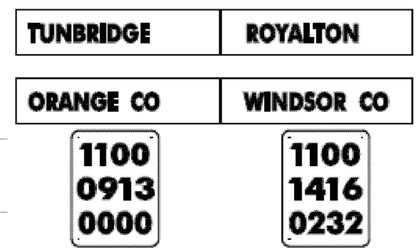	5.00					1			2		X										4	
		C	VD-025	72	10			5.00																				4	
		C	VD-700	6	10			0.42																					
		C	VD-700	6	10			0.42																					
NB	0.081	C	VR-017	24	24								1		X											BUTTON HILL RD TH-14			
		C	VR-017	24	30			5.00								1		X											E-141
NB	0.089	D	R1-1	30	30								1		X											BUTTON HILL RD TH-14			
		D	R1-1	30	30			6.25								1		X									X		
NB	0.490	A	W1-4L	30	30		LEFT REVERSE CURVE						1		X														
		A	W13-1	24	24		35 MPH PLAQUE						1																
NB	0.575	A	W1-2 L	30	30		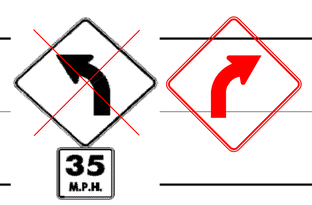	6.25								1		X								INSTALL 400' +/- NORTH OF ORIGINAL W1-4 SIGN LOCATION. 100' SOUTH OF GUARDRAIL BEG.	X		
		A	W13-1	24	24			4.00																			X		
NB	0.763	A	W1-4L	30	30		LEFT REVERSE CURVE POST & SIGNS NEW				~~1~~	~~1~~			X											INSTALL SALVAGED SIGNS ON NEW POST			
							SHEET TOTALS	32.34	0.00	0	~~1~~	~~1~~	~~6~~	0	0	5		75											
								SF	SF	EA	EA	EA	EA	EA	EA	EA		FT											
											0	0	7																
							TOWN TOTALS	743.6	0.0	47.0	7.0	7.0	122	0.0	0.0	133		1995.0											

SIGN SUMMARY SHEET

VERMONT AGENCY OF TRANSPORTATION

PROJECT NAME: Royalton-Barre Town VT110
PROJECT NUMBER: STPG SIGN(23)

FILE NAME: Tunbridge.xls
PROJECT MANAGER: N. Avery
DESIGNED BY: D. Crossley
TUNBRIDGE SHEET 1

PLOT DATE: 6/16/2009
DRAWN BY: T. Guazzoni
CHECKED BY: S. Menard
SHEET 14 OF 80