DIRECTION	MILEPOINT	LOCATION CODE (SHEET 2)	SIGN CODE	WIDTH (IN)	HEIGHT (IN)	SHEETING REMARKS	SIGN LEGEND	NEW SIGNS "A"	NEW SIGNS "B"	EXISTING SIGNS RETAIN	EXISTING SIGNS SALVAGE FROM	EXISTING SIGNS SALVAGE TO	EXISTING SIGNS REMOVE	EXIST POST RETAIN	EXIST POST REMOVE	NUMBER OF NEW POSTS	SQUARE STEEL (IN) 1.75 (LB / FT) 1.88	SQUARE STEEL (IN) 2.00 (LB / FT) 2.42	SQUARE STEEL (IN) 2.50 (LB / FT) 3.35	FOUNDATION	TUBULAR STEEL Ø (IN) 3.00 (LB / FT) 7.60	TUBULAR STEEL Ø (IN) 3.50 (LB / FT) 9.00	TUBULAR STEEL Ø (IN) 4.00 (LB / FT) 10.80	TUBULAR STEEL Ø (IN) 5.00 (LB / FT) 14.60	SIGN FRAME REQUIRED	REMARKS	SIGN DETAIL DETAIL IN SHS	SIGN DETAIL DETAIL ON SHEET NUMBER	SIGN DETAIL DETAIL ON STD SHEET NUMBER
TUNBRIDGE VT 110							FY-FLUORESCENT YELLOW FYG-FLUORESCENT YELLOW GREEN																			"SHS"-STANDARD HIGHWAY SIGNS			
		A	W3-5	36	36			9.00								2		X									X		
NB	4.450	A	VD-018	30	18								1		X														
		A	VD-018	30	18		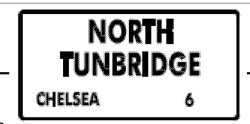	3.75								1		X											E-128B
NB	4.480	A	W1-1Ma R	30	30		RIGHT TURN W/ MINOR SIDE ROAD						1		X														
			W13-1	18	18		30 MPH PLAQUE						1																
NB	4.500	A	W1-1Ma R	30	30			6.25																		INSTALL 100' +/- NORTH OF ORIGINAL LOCATION		6	
			W13-1	24	24			4.00								1		X											
NB	4.530	A	R2-1	24	30								1		X														
		A	R2-1	30	36			7.50								1		X									X		
NB	4.540	A	W5-2	30	30			6.25								1		X								INSTALL 100'+/- NORTH OF SPEED LIMIT 35 SIGN. AT BEGINNING OF GUARDRAIL	X		
NB	4.568	A	OM-3 R	18	36								1		X														
			OM-3 R	12	36			3.00								1		X									X		
NB	4.572	B	OM -3 L	18	36								1		X														
			OM-3 L	12	36			3.00								1		X									X		
NB	4.800	A	R2-1	24	30			5.00								1		X								INSTALL AT M M 4.80	X		
							SHEET TOTALS	47.75	0.00	0	0	0	6	0	0	9		135											
								SF	SF	EA	EA	EA	EA	EA	EA	EA		FT											
							TOWN TOTALS	743.6	0.0	47.0	7.0	7.0	122	0.0	0.0	133		1995.0											

SIGN SUMMARY SHEET

VERMONT AGENCY OF TRANSPORTATION

PROJECT NAME: Royalton-Barre Town VT110
PROJECT NUMBER: STPG SIGN(23)

FILE NAME: Tunbridge.xls
PROJECT MANAGER: N. Avery
DESIGNED BY: D. Crossley
TUNBRIDGE SHEET 6

PLOT DATE: 6/16/2009
DRAWN BY: T. Guazzoni
CHECKED BY: S. Menard
SHEET 19 OF 80