DIRECTION	MILEPOINT	LOCATION CODE (SHEET 2)	SIGN CODE	WIDTH (IN)	HEIGHT (IN)	SHEETING REMARKS	SIGN LEGEND	NEW SIGNS "A"	NEW SIGNS "B"	EXISTING SIGNS RETAIN	EXISTING SIGNS SALVAGE FROM	EXISTING SIGNS SALVAGE TO	EXISTING SIGNS REMOVE	EXIST POST RETAIN	EXIST POST REMOVE	NUMBER OF NEW POSTS	SQUARE STEEL (IN) 1.75 (LB / FT) 1.88	SQUARE STEEL (IN) 2.00 (LB / FT) 2.42	SQUARE STEEL (IN) 2.50 (LB / FT) 3.35	FOUNDATION	TUBULAR STEEL Ø (IN) 3.00 (LB / FT) 7.60	TUBULAR STEEL Ø (IN) 3.50 (LB / FT) 9.00	TUBULAR STEEL Ø (IN) 4.00 (LB / FT) 10.80	TUBULAR STEEL Ø (IN) 5.00 (LB / FT) 14.60	SIGN FRAME REQUIRED	REMARKS	SIGN DETAIL: DETAIL IN SHS	SIGN DETAIL: DETAIL ON SHEET NUMBER	SIGN DETAIL: DETAIL ON STD SHEET NUMBER
TUNBRIDGE VT 110							FY-FLUORESCENT YELLOW FYG-FLUORESCENT YELLOW GREEN																			"SHS"-STANDARD HIGHWAY SIGNS			
		C	VR-017	24	30			5.00								1		X										E-141
NB	7.838	D	R1-1	30	30								1		X											BICKNELL HILL RD TH-6			
		D	R1-1	30	30			6.25								1		X									X		
NB	7.850	A	W1-6	48	24								1		X														
		A	W1-6	48	24			8.00								2		X									X		
NB	7.851	B	W1-6	48	24								1		X														
		B	W1-6	48	24			8.00								2		X									X		
SB	7.920	E	W1-6	48	24		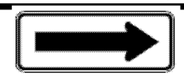	8.00					1			2		X							INSTALL 50' SOUTH OF LEFT ARROW THAT IS IN "F" POSITION FOR NB TRAFFIC	X		
SB	7.810	F	VD-217	54	8		JUSTIN MORGAN HORSE BURIAL SITE			1				X															
SB	7.700	F	W5-1	30	30		NARROW ROAD						1		X														
SB	7.750	F	W1-2R	30	30		RIGHT CURVE						1		X												X		
SB	7.680	F	VW-054L	30	30		HIDDEN DRIVE LEFT						1		X														
		F	W1-2R	30	30			6.25								1		X									X		
SB	7.650	F	VW-054L	30	30			6.25								1		X								INSTALL 150' SOUTH OF ORIGINAL SIGN LOCATION			E-154
SB	7.080	F	W1-2L	30	30		LEFT CURVE						1		X														
							SHEET TOTALS	47.75	0.00	1	0	0	~~7~~	0	0	10		150											
								SF	SF	EA	EA	EA	EA	EA	EA	EA		FT											
													8																
							TOWN TOTALS	743.6	0.0	47.0	7.0	7.0	122	0.0	0.0	133		1995.0											

SIGN SUMMARY SHEET

VERMONT AGENCY OF TRANSPORTATION

PROJECT NAME: Royalton-Barre Town VT110
PROJECT NUMBER: STPG SIGN(23)

FILE NAME: Tunbridge.xls
PROJECT MANAGER: N. Avery
DESIGNED BY: D. Crossley
TUNBRIDGE SHEET 11

PLOT DATE: 6/16/2009
DRAWN BY: T. Guazzoni
CHECKED BY: S. Menard
SHEET 24 OF 80