DIRECTION	MILEPOINT	LOCATION CODE (SHEET 2)	SIGN CODE	WIDTH (IN)	HEIGHT (IN)	SHEETING REMARKS	SIGN LEGEND	NEW SIGNS "A"	NEW SIGNS "B"	EXISTING SIGNS RETAIN	EXISTING SIGNS SALVAGE FROM	EXISTING SIGNS SALVAGE TO	EXISTING SIGNS REMOVE	EXIST POST RETAIN	EXIST POST REMOVE	NUMBER OF NEW POSTS	SQUARE STEEL (IN) 1.75 (LB / FT) 1.88	SQUARE STEEL (IN) 2.00 (LB / FT) 2.42	SQUARE STEEL (IN) 2.50 (LB / FT) 3.35	TUBULAR STEEL Ø (IN) FOUNDATION	TUBULAR STEEL Ø (IN) 3.00 (LB / FT) 7.60	TUBULAR STEEL Ø (IN) 3.50 (LB / FT) 9.00	TUBULAR STEEL Ø (IN) 4.00 (LB / FT) 10.80	TUBULAR STEEL Ø (IN) 5.00 (LB / FT) 14.60	SIGN FRAME REQUIRED	REMARKS	SIGN DETAIL: DETAIL IN SHS	SIGN DETAIL: DETAIL ON SHEET NUMBER	SIGN DETAIL: DETAIL ON STD SHEET NUMBER
TUNBRIDGE VT 110							FY-FLUORESCENT YELLOW FYG-FLUORESCENT YELLOW GREEN																		"SHS"-STANDARD HIGHWAY SIGNS			
		F	W13-1	24	24		40 MPH PLAQUE				1																	
SB	2.229	G	VR-017	24	30								1		X										HOWE LANE TH-45			
		G	VR-017	24	30			5.00								1		X										E-141
SB	2.221	H	R1-1	30	30								1		X										HOWE LANE TH-45			
		H	R1-1	30	30			6.25								1		X								X		
SB	2.219	F	W1-2L	30	30		CURVE LEFT					1				1		X							FROM MP 2.317			
		F	W13-1	24	24		40 MPH PLAQUE					1																
SB	2.180	F	W1-8L	24	18			3.00								1		X							INSTALL 200' +/- SOUTH OF SALVAGED CURVE SIGN. IN MIDDLE OF LEDGE AREA	X		
SB	2.179	E	W1-8R	24	18		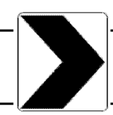	3.00								1		X							INSTALL 200' +/- SOUTH OF SALVAGED CURVE SIGN. IN MIDDLE OF LEDGE AREA	X		
SB	1.450	G	VR-017	24	30								1		X										HOWE LANE TH-53			
		G	VR-017	24	30			5.00								1		X										E-141
SB	1.450	H	R1-1	30	30								1		X										HOWE LANE TH-53			
		H	R1-1	30	30			6.25								1		X								X		
SB	1.240	F	W1-2R	30	30		RIGHT CURVE				1	1			X	1		X							INSTALL SALVAGED SIGN ON NEW POST			
SB	0.920	F	W1-4L	30	30								1		X													
							SHEET TOTALS	28.50	0.00	0	~~2~~ 1	3	5	0	0	8		120										
								SF	SF	EA	EA	EA	EA	EA	EA	EA		FT										
							TOWN TOTALS	743.6	0.0	47.0	7.0	7.0	122	0.0	0.0	133		1995.0										

SIGN SUMMARY SHEET

VERMONT AGENCY OF TRANSPORTATION

PROJECT NAME: Royalton-Barre Town VT110
PROJECT NUMBER: STPG SIGN(23)

FILE NAME: Tunbridge.xls
PROJECT MANAGER: N. Avery
DESIGNED BY: D. Crossley
TUNBRIDGE SHEET 20

PLOT DATE: 6/16/2009
DRAWN BY: T. Guazzoni
CHECKED BY: S. Menard
SHEET 33 OF 80