DIRECTION	MILEPOINT	LOCATION CODE (SHEET 2)	SIGN CODE	WIDTH (IN)	HEIGHT (IN)	SHEETING REMARKS	SIGN LEGEND	NEW SIGNS "A"	NEW SIGNS "B"	EXISTING SIGNS RETAIN	EXISTING SIGNS SALVAGE FROM	EXISTING SIGNS SALVAGE TO	EXISTING SIGNS REMOVE	EXIST POST RETAIN	EXIST POST REMOVE	NUMBER OF NEW POSTS	SQUARE STEEL (IN) 1.75 (LB / FT) 1.88	SQUARE STEEL (IN) 2.00 (LB / FT) 2.42	SQUARE STEEL (IN) 2.50 (LB / FT) 3.35	TUBULAR STEEL Ø (IN) FOUNDATION	TUBULAR STEEL Ø (IN) 3.00 (LB / FT) 7.60	TUBULAR STEEL Ø (IN) 3.50 (LB / FT) 9.00	TUBULAR STEEL Ø (IN) 4.00 (LB / FT) 10.80	TUBULAR STEEL Ø (IN) 5.00 (LB / FT) 14.60	SIGN FRAME REQUIRED	REMARKS	SIGN DETAIL: DETAIL IN SHS	SIGN DETAIL: DETAIL ON SHEET NUMBER	SIGN DETAIL: DETAIL ON STD SHEET NUMBER
CHELSEA VT 110							FY-FLUORESCENT YELLOW FYG-FLUORESCENT YELLOW GREEN																		"SHS"-STANDARD HIGHWAY SIGNS			
NB	0.000	C	VD-024	60	7.5								3 ~~1~~		X													
		C	VD-024	72	10			5.00								2		X									4	
		C	VD-700	6	10		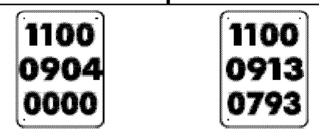	0.42																				
		C	VD-700	6	10			0.42																				
NB	0.507	A	W2-2MR	30	30		RIGHT SIDE ROAD			1				X														
		A	W16-8A	30	8		MOXLEY RD			1																		
NB	0.516	C	VR-017	24	24								1		X										MOXLEY RD TH-68			
		C	VR-017	24	24			5.00								1		X										E-141
NB	0.524	D	R1-1	24	24							1	1		X										MOXLEY RD TH-68			
		D	R1-1	24	24			6.25								1		X								X		
NB	0.630	F	OM-3 R	12	36								1		X													
		F	OM-3 R	12	36			3.00								1		X								X		
NB	0.640	F	OM-3 L	12	36								1		X													
		E	OM-3 L	12	36			3.00								1		X								X		
NB	0.770	A	D1-1	54	7.5								1		X													
							SHEET TOTALS	23.09	0.00	2	0	~~0~~	~~6~~	0	0	6		90										
								SF	SF	EA	EA	EA	EA	EA	EA	EA		FT										
												1	8															
							TOWN TOTALS	539.5	0.0	59.0	5.0	5.0	107	0.0	0.0	96		1440.0										

SIGN SUMMARY SHEET

VERMONT AGENCY OF TRANSPORTATION

PROJECT NAME: Royalton-Barre Town VT110
PROJECT NUMBER: STPG SIGN(23)

FILE NAME: Chelsea.xls
PROJECT MANAGER: N. Avery
DESIGNED BY: D. Crossley
CHELSEA SHEET 1

PLOT DATE: 6/15/2009
DRAWN BY: T. Guazzoni
CHECKED BY: S. Menard
SHEET 35 OF 80