DIRECTION	MILEPOINT	LOCATION CODE (SHEET 2)	SIGN CODE	WIDTH (IN)	HEIGHT (IN)	SHEETING REMARKS	SIGN LEGEND	NEW SIGNS "A"	NEW SIGNS "B"	EXISTING SIGNS RETAIN	EXISTING SIGNS SALVAGE FROM	EXISTING SIGNS SALVAGE TO	EXISTING SIGNS REMOVE	EXIST POST RETAIN	EXIST POST REMOVE	NUMBER OF NEW POSTS	SQUARE STEEL (IN) (LB / FT) 1.75 / 2.00 / 2.50	1.88	2.42	3.35	FOUNDATION	TUBULAR STEEL Ø (IN) (LB / FT) 3.00 / 3.50 / 4.00 / 5.00	7.60	9.00	10.80	14.60	SIGN FRAME REQUIRED	REMARKS	SIGN DETAIL: DETAIL IN SHS	DETAIL ON SHEET NUMBER	DETAIL ON STD SHEET NUMBER
CHELSEA		**VT 110**					FY-FLUORESCENT YELLOW FYG-FLUORESCENT YELLOW GREEN																				"SHS"-STANDARD HIGHWAY SIGNS			
NB	2.907	A	D1-1A	72	10								1		X																
		A	D1-1A	72	10								1																		
		A	D1-1A	72	10								1																		
		A	D1-1A	72	10								1																		
		A	D1-1A	72	12		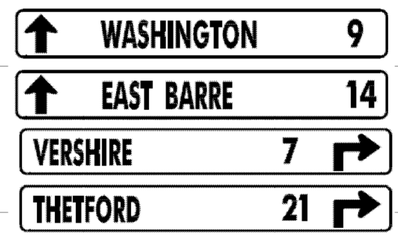	6.00								2			X									5	
		A	D1-1A	72	12			6.00																					5	
		A	D1-1A	72	12			6.00																					5	
		A	D1-1A	72	12			6.00																					5	
NB	2.917	D	R1-1	24	24						2	2	1		X												COURT ST TH-30			
		D	R1-1	30	30			6.25								1		X										X		
NB	2.908	A	S1-1YG	30	30		SCHOOL			1				X																	
		A	W16-7YG	24	12		DOWN ARROW			1																					
NB	2.950	A	M3-1S	24	12		NORTH			1				X																	
		A	M1-5	30	24		VERMONT 110			1																					
		A	M6-3S	21	15		^UP ARROW			1																					
							SHEET TOTALS	30.25	0.00	5	~~0~~	~~0~~	5	0	0	3		45													
								SF	SF	EA	EA	EA	EA	EA	EA	EA		FT													
							TOWN TOTALS	539.5	0.0	59.0	2 5.0	2 5.0	107	0.0	0.0	96		1440.0													

SIGN SUMMARY SHEET

VERMONT AGENCY OF TRANSPORTATION

PROJECT NAME: Royalton-Barre Town VT110
PROJECT NUMBER: STPG SIGN(23)

FILE NAME: Chelsea.xls
PROJECT MANAGER: N. Avery
DESIGNED BY: D. Crossley
CHELSEA SHEET 6

PLOT DATE: 6/15/2009
DRAWN BY: T. Guazzoni
CHECKED BY: S. Menard