DIRECTION	MILEPOINT	LOCATION CODE (SHEET 2)	SIGN CODE	WIDTH (IN)	HEIGHT (IN)	SHEETING REMARKS	SIGN LEGEND	NEW SIGNS "A"	NEW SIGNS "B"	EXISTING SIGNS RETAIN	EXISTING SIGNS SALVAGE FROM	EXISTING SIGNS SALVAGE TO	EXISTING SIGNS REMOVE	EXIST POST RETAIN	EXIST POST REMOVE	NUMBER OF NEW POSTS	SQUARE STEEL (IN) (LB / FT) 1.75 / 1.88	2.00 / 2.42	2.50 / 3.35	FOUNDATION	TUBULAR STEEL Ø (IN) (LB / FT) 3.00 / 7.60	3.50 / 9.00	4.00 / 10.80	5.00 / 14.60	SIGN FRAME REQUIRED	REMARKS	SIGN DETAIL: DETAIL IN SHS	DETAIL ON SHEET NUMBER	DETAIL ON STD SHEET NUMBER
CHELSEA VT 110							FY-FLUORESCENT YELLOW FYG-FLUORESCENT YELLOW GREEN																			"SHS"-STANDARD HIGHWAY SIGNS			
SB	1.260	F	W1-2L	30	30			6.25								1		X								INSTALL 300'+/- SOUTH OF ORIGINAL SIGN LOCATION	X		
		F	W13-1	24	24			4.00																			X		
SB	0.830	F	D1-1A	72	10								1		X														
		F	D1-1A	72	12		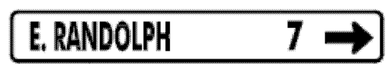	6.00								2		X										5	
SB	0.784	G	VR-017	24	24		LEGAL LOAD LIMIT 24,000 LBS 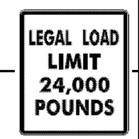						1		X											EAST RANDOLPH RD TH-1			
SB	0.770	G	VR-017	24	30			5.00								1		X											E-141
SB	0.776	H	R1-1	24	24								1		X											EAST RANDOLPH RD TH-1			
		H	R1-1	30	30			6.25								1		X								ISLAND	X		
SB	0.776	G	R1-2	30	30		YIELD			1				X												ISLAND			
SB	0.768	H	R1-1	24	24								1		X											EAST RANDOLPH RD TH-1			
		H	R1-1	30	30			6.25								1		X									X		
SB	0.740	F	M3-3	24	12								1		X														
		F	M1-5	30	24								0 ~~1~~																
		F	M3-3	24	12			2.00								1		X								GREEN ON WHITE SHEETING	X		
		F	M1-5	30	24			5.00																					E-136B
							SHEET TOTALS	40.75	0.00	1	0	0	~~6~~	0	0	7		105											
								SF	SF	EA	EA	EA	EA	EA	EA	EA		FT											
							TOWN TOTALS	539.5	0.0	59.0	5.0	5.0	5 107	0.0	0.0	96		1440.0											

SIGN SUMMARY SHEET

VERMONT AGENCY OF TRANSPORTATION

PROJECT NAME: Royalton-Barre Town VT110
PROJECT NUMBER: STPG SIGN(23)

FILE NAME: Chelsea.xls
PROJECT MANAGER: N. Avery
DESIGNED BY: D. Crossley
CHELSEA SHEET 18

PLOT DATE: 6/15/2009
DRAWN BY: T. Guazzoni
CHECKED BY: S. Menard
SHEET 52 OF 80