DIRECTION	MILEPOINT	LOCATION CODE (SHEET 2)	SIGN CODE	WIDTH (IN)	HEIGHT (IN)	SHEETING REMARKS	SIGN LEGEND	NEW SIGNS "A"	NEW SIGNS "B"	EXISTING SIGNS RETAIN	EXISTING SIGNS SALVAGE FROM	EXISTING SIGNS SALVAGE TO	EXISTING SIGNS REMOVE	EXIST POST RETAIN	EXIST POST REMOVE	NUMBER OF NEW POSTS	SQUARE STEEL (IN) (LB / FT) 1.75 / 2.00 / 2.50	1.88	2.42	3.35	FOUNDATION	TUBULAR STEEL Ø (IN) (LB / FT) 3.00 / 3.50 / 4.00 / 5.00	7.60	9.00	10.80	14.60	SIGN FRAME REQUIRED	REMARKS	SIGN DETAIL: DETAIL IN SHS	DETAIL ON SHEET NUMBER	DETAIL ON STD SHEET NUMBER
ORANGE VT110							FY-FLUORESCENT YELLOW FYG-FLUORESCENT YELLOW GREEN																				"SHS"-STANDARD HIGHWAY SIGNS			
NB	0.000	C	VD-024	60	7.5								~~1~~ 2		X																
		C	VD-025	72	10		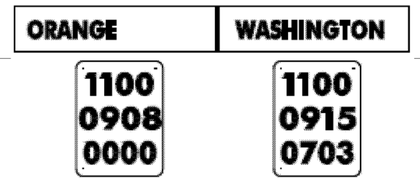	5.00								2		X										4	
		C	VD-700	6	10			0.42																			ORANGE MILE MARKER ~ INSTALL ON LEFT POST			E-138
		C	VD-700	6	10			0.42																			WASHINGTON MILE MARKER ~ INSTALL ON RIGHT POST			E-138
NB	0.075	A	W11-6H	30	30								1		X																
		A	W11-6H	30	30			6.25								1		X									INSTALL IN CLOSED POSITION			E-153
NB	0.305	A	W2-2	30	30		SIDE RD WARNING 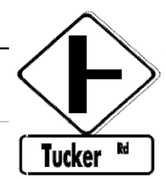						1		X																
NB	0.340	A	W2-2MaR	30	30			6.25								1		X									INSTALL 175 FT +/- NORTH OF EXISTING, IN FRONT OF NEXT UTILITY POLE		6	
		A	W16-8	24	8			1.33																					4	
NB	0.405	C	VR-017	24	24								1		X																
		C	VR-017	24	30			5.00								1		X									TH-2, TUCKER RD			E-141
NB	0.415	D	R1-1	30	30								1		X																
		D	R1-1	30	30			6.25								1		X									TH-2, TUCKER RD	X		
NB	1.460	A	W1-2L	30	30								1		X																
		A	W1-2L	30	30			6.25								1		X										X		
							SHEET TOTALS	37.17	0.00	0	0	0	~~6~~	0	0	7		105												
								SF	SF	EA	EA	EA	EA	EA	EA	EA		FT												
							TOWN TOTALS	56.7	0.0	3.0	1.0	1.0	7 9	0.0	0.0	11		165.0												

SIGN SUMMARY SHEET

VERMONT AGENCY OF TRANSPORTATION

PROJECT NAME: Royalton-Barre Town VT110
PROJECT NUMBER: STPG SIGN(23)

FILE NAME: Orange.xls
PROJECT MANAGER: N. Avery
DESIGNED BY: A. Gamble
ORANGE SHEET 1

PLOT DATE: 6/15/2009
DRAWN BY: T. Guazzoni
CHECKED BY: S. Menard