DIRECTION	MILEPOINT	LOCATION CODE (SHEET 2)	SIGN CODE	WIDTH (IN)	HEIGHT (IN)	SHEETING REMARKS	SIGN LEGEND	NEW SIGNS "A"	NEW SIGNS "B"	EXISTING SIGNS RETAIN	EXISTING SIGNS SALVAGE FROM	EXISTING SIGNS SALVAGE TO	EXISTING SIGNS REMOVE	EXIST POST RETAIN	EXIST POST REMOVE	NUMBER OF NEW POSTS	SQUARE STEEL (IN) 1.75 (LB / FT) 1.88	SQUARE STEEL (IN) 2.00 (LB / FT) 2.42	SQUARE STEEL (IN) 2.50 (LB / FT) 3.35	FOUNDATION	TUBULAR STEEL Ø (IN) 3.00 (LB / FT) 7.60	TUBULAR STEEL Ø (IN) 3.50 (LB / FT) 9.00	TUBULAR STEEL Ø (IN) 4.00 (LB / FT) 10.80	TUBULAR STEEL Ø (IN) 5.00 (LB / FT) 14.60	SIGN FRAME REQUIRED	REMARKS	SIGN DETAIL: DETAIL IN SHS	SIGN DETAIL: DETAIL ON SHEET NUMBER	SIGN DETAIL: DETAIL ON STD SHEET NUMBER
BARRE TOWN			**VT 110**				FY-FLUORESCENT YELLOW FYG-FLUORESCENT YELLOW GREEN																			"SHS"-STANDARD HIGHWAY SIGNS			
NB	0.000	C	VD-025	60	7.5								1		X													
		C	VD-024	60	7.5								0 ~~1~~															
		C	VD-025	72	10		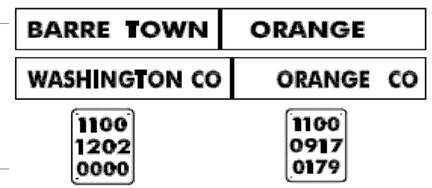	5.00								2		X								4	
		C	VD-024	72	10			5.00																			4	
		C	VD-700	6	10			0.42																		BARRE TOWN MILE MARKER ~ INSTALL ON LEFT POST			E-138
		C	VD-700	6	10			0.42																		ORANGE MILE MARKER ~ INSTALL ON RIGHT POST			E-138
NB	0.400	A	W11-6	30	30								2 ~~1~~		X													
		A	W11-6H	30	30		REMOVE PER TRAFFIC OPPS.	6.25								1		X								INSTALL IN CLOSED POSITION			E-153
NB	0.530	A	R2-5A	24	30		REDUCED SPEED AHEAD						1		X													
		A	W3-5	36	36			9.00								2		X									X	
NB	0.601	A	VD-062A	72	16		BUSINESS SIGN			1				X														
		A	VD-062A	72	16		BUSINESS SIGN			1																		
NB	0.640	A	VD-018	30	18								1		x													
		A	VD-018	30	18			3.75								1		X										E-128A
NB	0.680	A	W11-2	30	30								1		X													
							SHEET TOTALS	29.84	0.00	2	0	0	6	0	0	6		90										
								SF	SF	EA	EA	EA	EA	EA	EA	EA		FT										
							TOWN TOTALS	258.0	0.0	29.0	4.0	4.0	50	0.0	0.0	41		615.0										

SIGN SUMMARY SHEET

VERMONT AGENCY OF TRANSPORTATION

PROJECT NAME: Royalton-Barre Town VT110
PROJECT NUMBER: STPG SIGN(23)

FILE NAME: Barre Town.xls
PROJECT MANAGER: N. Avery
DESIGNED BY: A. Gamble
BARRE TOWN SHEET 1

PLOT DATE: 6/15/2009
DRAWN BY: T. Guazzoni
CHECKED BY: S. Menard