| DIRECTION | MILEPOINT | LOCATION CODE (SHEET 2) | SIGN CODE | WIDTH (IN) | HEIGHT (IN) | SHEETING REMARKS | SIGN LEGEND | NEW SIGNS "A" | NEW SIGNS "B" | EXISTING SIGNS RETAIN | EXISTING SIGNS SALVAGE FROM | EXISTING SIGNS SALVAGE TO | EXISTING SIGNS REMOVE | EXIST POST RETAIN | EXIST POST REMOVE | NUMBER OF NEW POSTS | SQUARE STEEL (IN) 1.75 (LB / FT) 1.88 | SQUARE STEEL (IN) 2.00 (LB / FT) 2.42 | SQUARE STEEL (IN) 2.50 (LB / FT) 3.35 | FOUNDATION | TUBULAR STEEL Ø (IN) 3.00 (LB / FT) 7.60 | TUBULAR STEEL Ø (IN) 3.50 (LB / FT) 9.00 | TUBULAR STEEL Ø (IN) 4.00 (LB / FT) 10.80 | TUBULAR STEEL Ø (IN) 5.00 (LB / FT) 14.60 | SIGN FRAME REQUIRED | REMARKS | SIGN DETAIL DETAIL IN SHS | SIGN DETAIL DETAIL ON SHEET NUMBER | SIGN DETAIL DETAIL ON STD SHEET NUMBER |
|---|---|---|---|---|---|---|---|---|---|---|---|---|---|---|---|---|---|---|---|---|---|---|---|---|---|---|---|---|---|
| **BARRE TOWN** | | | **VT 110** | | | | FY-FLUORESCENT YELLOW<br>FYG-FLUORESCENT YELLOW GREEN | | | | | | | | | | | | | | | | | | | "SHS"-STANDARD HIGHWAY SIGNS | | | |
| | | H | R1-1 | 30 | 30 | | | 6.25 | | | | | | | | 1 | | X | | | | | | | | TH-125, OLD 302 | X | | |
| SB | 1.050 | F | D1-1A | 54 | 7.5 | | | | | | | | 1 | | X | | | | | | | | | | | | | | |
| | | F | D1-1A | 54 | 7.5 | | | | | | | | 1 | | | | | | | | | | | | | | | | |
| | | F | D1-1 | 54 | 7.5 | | | | | | | | 1 | | | | | | | | | | | | | | | | |
| | | F | D1-1 | 54 | 7.5 | | | | | | | | 1 | | | | | | | | | | | | | | | | |
| | | F | D1-1 | UNK | | | EAST BARRE SHOPPING AREA | | | | | | 1 | | | | | | | | | | | | | REMOVE AND DO NOT REPLACE TOWN DIRECTIONAL SIGN | | | |
| | | F | D1-1 | UNK | | | GRANITE QUARRIES | | | | | | 1 | | | | | | | | | | | | | REMOVE AND DO NOT REPLACE TOWN DIRECTIONAL SIGN | | | |
| | | F | D1-1 | UNK | | | MILLSTONE HILL | | | | | | 1 | | | | | | | | | | | | | REMOVE AND DO NOT REPLACE TOWN DIRECTIONAL SIGN | | | |
| | | F | D1-1A | 72 | 12 | | 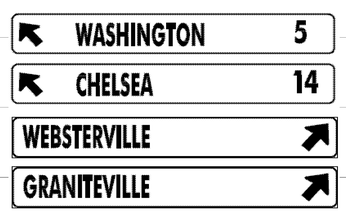  | 6.00 | | | | | | | | 2 | | | X | | | | | | | | | 5 |
| | | F | D1-1A | 72 | 12 | | | 6.00 | | | | | | | | | | | | | | | | | | | | | 5 |
| | | F | D1-1 | 72 | 12 | | | 6.00 | | | | | | | | | | | | | | | | | | | | | 5 |
| | | F | D1-1 | 72 | 12 | | | 6.00 | | | | | | | | | | | | | | | | | | | | | 5 |
| SB | 1.049 | F | M3-3 | 24 | 12 | | | | | | | | 1 | | X | | | | | | | | | | | | | | |
| | | F | M1-5A | 24 | 24 | | | | | | | | 1 | | | | | | | | | | | | | | | | |
| | | F | M6-2 | 21 | 15 | | | | | | | | 1 | | | | | | | | | | | | | | | | |
| | | | | | | | SHEET TOTALS | 30.25 | 0.00 | 0 | 0 | 0 | 10 | 0 | 0 | 3 | | 45 | | | | | | | | | | | |
| | | | | | | | | SF | SF | EA | EA | EA | EA | EA | EA | EA | | FT | | | | | | | | | | | |
| | | | | | | | TOWN TOTALS | 258.0 | 0.0 | 29.0 | 4.0 | 4.0 | 50 | 0.0 | 0.0 | 41 | | 615.0 | | | | | | | | | | | |

# SIGN SUMMARY SHEET

VERMONT AGENCY OF TRANSPORTATION

PROJECT NAME: Royalton-Barre Town VT110
PROJECT NUMBER: STPG SIGN(23)

FILE NAME: Barre Town.xls
PROJECT MANAGER: N. Avery
DESIGNED BY: A. Gamble
BARRE TOWN SHEET 7

PLOT DATE: 6/15/2009
DRAWN BY: T. Guazzoni
CHECKED BY: S. Menard
SHEET 74 OF 80