DIRECTION	MILEPOINT	LOCATION CODE (SHEET 2)	SIGN CODE	WIDTH (IN)	HEIGHT (IN)	SHEETING REMARKS	SIGN LEGEND	NEW SIGNS "A"	NEW SIGNS "B"	EXISTING SIGNS RETAIN	EXISTING SIGNS SALVAGE FROM	EXISTING SIGNS SALVAGE TO	EXISTING SIGNS REMOVE	EXIST POST RETAIN	EXIST POST REMOVE	NUMBER OF NEW POSTS	SQUARE STEEL (IN) 1.75 (LB / FT) 1.88	SQUARE STEEL (IN) 2.00 (LB / FT) 2.42	SQUARE STEEL (IN) 2.50 (LB / FT) 3.35	FOUNDATION	TUBULAR STEEL Ø (IN) 3.00 (LB / FT) 7.60	TUBULAR STEEL Ø (IN) 3.50 (LB / FT) 9.00	TUBULAR STEEL Ø (IN) 4.00 (LB / FT) 10.80	TUBULAR STEEL Ø (IN) 5.00 (LB / FT) 14.60	SIGN FRAME REQUIRED	REMARKS	SIGN DETAIL: DETAIL IN SHS	SIGN DETAIL: DETAIL ON SHEET NUMBER	SIGN DETAIL: DETAIL ON STD SHEET NUMBER
STAMFORD VT 100							FY-FLUORESCENT YELLOW FYG-FLUORESCENT YELLOW GREEN																			"SHS"-STANDARD HIGHWAY SIGNS			
		F	W11-7	30	30		EQUESTRIAN						1															
		F	W7-3A	24	30		NEXT 2 MILES						1															
SB	1.776	G	VR-017	24	30								1		X													
		G	VR-017	24	30			5.00								1		X								TH-11, OLD COUNTY RD			E-141
SB	1.768	H	R1-1	30	30			6.25								1		X								TH-11, OLD COUNTY RD	X		
SB	1.756	F	N/A	30	30		EMPTY POST								X													
SB	1.708	F	W1-2L	30	30			6.25								1		X								INSTALL 250 FEET SOUTH OF EXISTING EMPTY POST LOCATION AND SOUTH OF MAILBOXES	X		
		F	W13-1	18	18			2.25																			X		
SB	1.505	F	R2-1	24	30								1		X													
		F	R2-1	24	30			5.00								1		X									X		
SB	1.270	F	R2-5A	24	30		REDUCED SPEED AHEAD						1		X													
		F	W3-5	36	36			9.00								2		X									X		
	1.214	F	VD-018	30	18		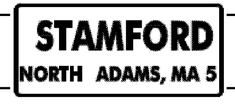	3.75								1		X								INSTALL ON NORTH SIDE OF UTILITY POLE WITH TWO GUY WIRES			E-128A
SB	1.170	F	R2-1	24	30								1		X													
		F	R2-1	30	36			7.50								1		X										6		
SIGN SUMMARY SHEET							SHEET TOTALS	45.00	0.00	0	0	0	6	0	0	8		120										
								SF	SF	EA	EA	EA	EA	EA	EA	EA		FT										
VERMONT AGENCY OF TRANSPORTATION							TOWN TOTALS	455.0	0.0	16.0	5.0	5.0	75	0.0	0.0	83		1245.0										

PROJECT NAME: **Stamford-Andover VT100**
PROJECT NUMBER: **STPG SIGN(20)**

FILE NAME: **Stamford.xls** PLOT DATE: **8/5/2009**
PROJECT MANAGER: **N. Avery** DRAWN BY: **T. Guazzoni**
DESIGNED BY: **J. Kelly** CHECKED BY: **T. Guazzoni**
STAMFORD SHEET 9 SHEET **17** OF **198**