DIRECTION	MILEPOINT	LOCATION CODE (SHEET 2)	SIGN CODE	WIDTH (IN)	HEIGHT (IN)	SHEETING REMARKS	SIGN LEGEND	NEW SIGNS "A"	NEW SIGNS "B"	EXISTING SIGNS RETAIN	EXISTING SIGNS SALVAGE FROM	EXISTING SIGNS SALVAGE TO	EXISTING SIGNS REMOVE	EXIST POST RETAIN	EXIST POST REMOVE	NUMBER OF NEW POSTS	SQUARE STEEL (IN) 1.75 (LB / FT) 1.88	SQUARE STEEL (IN) 2.00 (LB / FT) 2.42	SQUARE STEEL (IN) 2.50 (LB / FT) 3.35	FOUNDATION	TUBULAR STEEL Ø (IN) 3.00 (LB / FT) 7.60	TUBULAR STEEL Ø (IN) 3.50 (LB / FT) 9.00	TUBULAR STEEL Ø (IN) 4.00 (LB / FT) 10.80	TUBULAR STEEL Ø (IN) 5.00 (LB / FT) 14.60	SIGN FRAME REQUIRED	REMARKS	SIGN DETAIL: DETAIL IN SHS	SIGN DETAIL: DETAIL ON SHEET NUMBER	SIGN DETAIL: DETAIL ON STD SHEET NUMBER
READSBORO			**VT 100**				FY-FLUORESCENT YELLOW FYG-FLUORESCENT YELLOW GREEN																			"SHS"-STANDARD HIGHWAY SIGNS			
		F	D2-1	72	12		NO ADAMS MA			1																		
SB	2.073	F	VD-018	30	18		ADD "E" TO WORD 						~~1~~		~~X~~											OLD SIGN WAS MISSING			
		F	VD-018	30	18			3.75								1		X										E-128A
SB	2.068	E	W1-6	48	24								1		X													
		E	W1-6	48	24			8.00								2		X								X		
SB	2.054	G	VR-017	24	30								1		X											OLD COUNTY LANE TH-35, ~~HEARTWELLVILLE RD~~			
		G	VR-017	24	30			5.00								1		X										E-141
SB	2.054	H	R1-1	30	30		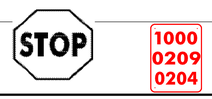						1		X											OLD COUNTY LANE TH-35, ~~HEARTWELLVILLE RD~~			
		H	R1-1	30	30			6.25								1		X								X		
SB	1.573	F	W1-2L	30	30								1		X													
		F	W1-2L	30	30			6.25								1		X								X		
SB	1.488	G	VR-017	24	30								1		X											TH-36, WILLIAMS RD (NORTH)			
		G	VR-017	24	30			5.00								1		X										E-141
SB	1.480	H	R1-1	30	30								1		X											TH-36, WILLIAMS RD (NORTH)			
		H	R1-1	30	30			6.25								1		X								X		
							SHEET TOTALS	40.50	0.00	1	0	0	~~7~~ 6	0	0	8		120										
								SF	SF	EA	EA	EA	EA	EA	EA	EA		FT										
							TOWN TOTALS	408.4	0.0	34.0	3.0	3.0	84	0.0	2.0	64		960.0										

SIGN SUMMARY SHEET

VERMONT AGENCY OF TRANSPORTATION

PROJECT NAME: **Stamford-Andover VT100**
PROJECT NUMBER: **STPG SIGN(20)**

FILE NAME: **Readsboro.xls**
PROJECT MANAGER: **N. Avery**
DESIGNED BY: **J. Kelly**
READSBORO SHEET 14

PLOT DATE: **8/5/2009**
DRAWN BY: **T. Guazzoni**
CHECKED BY: **T. Guazzoni**
SHEET **35** OF **198**