DIRECTION	MILEPOINT	LOCATION CODE (SHEET 2)	SIGN CODE	WIDTH (IN)	HEIGHT (IN)	SHEETING REMARKS	SIGN LEGEND	NEW SIGNS "A"	NEW SIGNS "B"	EXISTING SIGNS RETAIN	EXISTING SIGNS SALVAGE FROM	EXISTING SIGNS SALVAGE TO	EXISTING SIGNS REMOVE	EXIST POST RETAIN	EXIST POST REMOVE	NUMBER OF NEW POSTS	SQUARE STEEL (IN) 1.75 (LB / FT) 1.88	SQUARE STEEL (IN) 2.00 (LB / FT) 2.42	SQUARE STEEL (IN) 2.50 (LB / FT) 3.35	TUBULAR STEEL Ø (IN) FOUNDATION	TUBULAR STEEL Ø (IN) 3.00 (LB / FT) 7.60	TUBULAR STEEL Ø (IN) 3.50 (LB / FT) 9.00	TUBULAR STEEL Ø (IN) 4.00 (LB / FT) 10.80	TUBULAR STEEL Ø (IN) 5.00 (LB / FT) 14.60	SIGN FRAME REQUIRED	REMARKS	SIGN DETAIL: DETAIL IN SHS	SIGN DETAIL: DETAIL ON SHEET NUMBER	SIGN DETAIL: DETAIL ON STD SHEET NUMBER
WHITINGHAM VT 100							FY-FLUORESCENT YELLOW FYG-FLUORESCENT YELLOW GREEN																			"SHS"-STANDARD HIGHWAY SIGNS			
		A	D1-1A	72	10		GREENFIELD MASS 26 MODIFIED RIGHT ARROW						1																
NB	7.553	A	VR-020	24	30		NO PARKING ON TRAVELED LANE						1		X														
		A	D2-1	72	12			6.00								2		X								5	
		A	D1-1A	72	12			6.00																		5	
NB	7.598	A	M3-1	24	12			2.00								2			X						#3B	INSTALL ON SOUTH SIDE OF UTILTY POLE AT BEGINNING OF RETAINING WALL. GREEN ON WHITE SHEETING	X	7	
		A	M1-5	30	24			5.00																				E-136B
		A	M6-3	21	15			2.19																		GREEN ON WHITE SHEETING	X		
		A	M3-3	24	12			2.00																		GREEN ON WHITE SHEETING	X		
		A	M1-5	30	24			5.00																				E-136B
		A	VM-013R	21	15		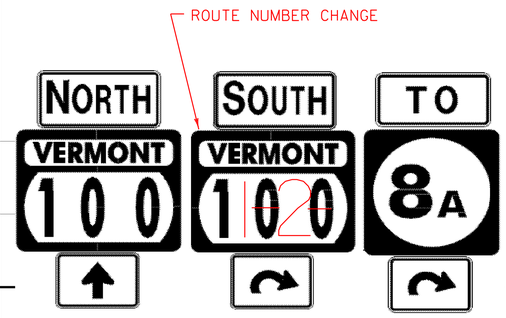	2.19																GREEN ON WHITE SHEETING		6	
		A	M4-5	24	12			2.00																		BLACK ON WHITE SHEETING	X		
		A	M1-6	24	24			4.00																				E-136C
		A	VM-013R	21	15			2.19																		BLACK ON WHITE SHEETING		6	
NB	7.604	A	OM-3R	12	36								1		X														
		A	OM-3R	12	36		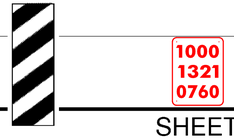	3.00								1			X							INSTALL AT EDGE OF PAVEMENT IN FRONT OF RETAINING WALL	X		
							SHEET TOTALS	41.57 SF	0.00 SF	0 EA	0 EA	0 EA	3 EA	0 EA	0 EA	5 EA		75 FT								
							TOWN TOTALS	1058.3	0.0	40.0	13.0	13.0	220	0.0	0.0	193		2895.0								

SIGN SUMMARY SHEET

VERMONT AGENCY OF TRANSPORTATION

PROJECT NAME: **Stamford-Andover VT100**
PROJECT NUMBER: **STPG SIGN(20)**

FILE NAME: **Whitingham.xls**
PROJECT MANAGER: **N. Averv**
DESIGNED BY: **J. Kelly**
WHITINGHAM SHEET 15

PLOT DATE: **8/5/2009**
DRAWN BY: **I. Shea**
CHECKED BY: **T. Guazzoni**
SHEET **51** OF **198**