DIRECTION	MILEPOINT	LOCATION CODE (SHEET 2)	SIGN CODE	WIDTH (IN)	HEIGHT (IN)	SHEETING REMARKS	SIGN LEGEND	NEW SIGNS "A"	NEW SIGNS "B"	EXISTING SIGNS RETAIN	EXISTING SIGNS SALVAGE FROM	EXISTING SIGNS SALVAGE TO	EXISTING SIGNS REMOVE	EXIST POST RETAIN	EXIST POST REMOVE	NUMBER OF NEW POSTS	SQUARE STEEL (IN) 1.75 (LB / FT) 1.88	SQUARE STEEL (IN) 2.00 (LB / FT) 2.42	SQUARE STEEL (IN) 2.50 (LB / FT) 3.35	FOUNDATION	TUBULAR STEEL Ø (IN) 3.00 (LB / FT) 7.60	TUBULAR STEEL Ø (IN) 3.50 (LB / FT) 9.00	TUBULAR STEEL Ø (IN) 4.00 (LB / FT) 10.80	TUBULAR STEEL Ø (IN) 5.00 (LB / FT) 14.60	SIGN FRAME REQUIRED	REMARKS	SIGN DETAIL: DETAIL IN SHS	SIGN DETAIL: DETAIL ON SHEET NUMBER	SIGN DETAIL: DETAIL ON STD SHEET NUMBER
WHITINGHAM VT 100							FY-FLUORESCENT YELLOW FYG-FLUORESCENT YELLOW GREEN																			"SHS"-STANDARD HIGHWAY SIGNS			
		F	W7-1B	30	30			6.25								2		X									X	
		F	W7-2B	24	18			3.00																		INSTALL ON LEFT HAND POST	X	
		F	W7-3a	24	18			3.00																		INSTALL ON RIGHT HAND POST	X	
SB	0.860	F	W1-1L	30	30		LEFT TURN						1		X													
		F	W13-1	18	18		30 MPH PLAQUE						1															
		F	W1-5L	30	30			6.25								2		X									X	
		F	W13-1	18	18			2.25																		INSTALL ON LEFT HAND POST		
		F	W7-3a	24	18			3.00																		INSTALL ON RIGHT HAND POST	X	
SB	0.788	F	W1-1L	30	30			6.25								1										INSTALL 100 FEET NORTH OF DRIVE ON CORNER	X	
		F	W13-1	18	18			2.25																			X	
SB	0.683	F	R2-1	24	30								1		X													
		F	R2-1	24	30			5.00								1		X									X	
SB	0.268	F	OM-3R	12	36								1		X													
		F	OM-3R	12	36			3.00								1		X									X	
SB	0.264	E	OM-3L	12	36								1		X													
							SHEET TOTALS	40.25	0.00	0	0	0	~~5~~ 6	0	0	~~6~~ 7		90										
								SF	SF	EA	EA	EA	EA	EA	EA	EA		FT										
							TOWN TOTALS	1058.3	0.0	40.0	13.0	13.0	220	0.0	0.0	193		2895.0										

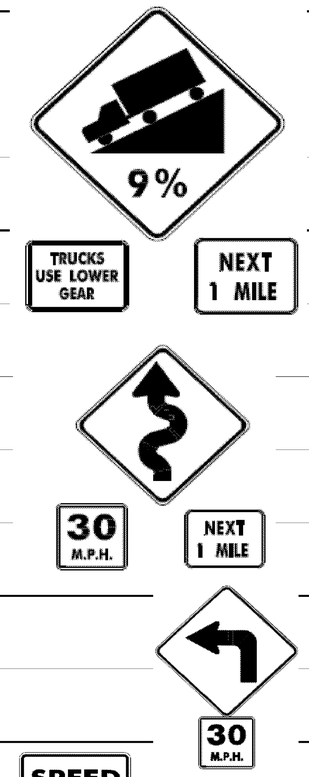

SIGN SUMMARY SHEET

VERMONT AGENCY OF TRANSPORTATION

PROJECT NAME: Stamford-Andover VT100
PROJECT NUMBER: STPG SIGN(20)

FILE NAME: Whitingham.xls
PROJECT MANAGER: N. Avery
DESIGNED BY: J. Kelly
WHITINGHAM SHEET 33

PLOT DATE: 8/5/2009
DRAWN BY: I. Shea
CHECKED BY: T. Guazzoni
SHEET 69 OF 198