DIRECTION	MILEPOINT	LOCATION CODE (SHEET 2)	SIGN CODE	WIDTH (IN)	HEIGHT (IN)	SHEETING REMARKS	SIGN LEGEND	NEW SIGNS "A"	NEW SIGNS "B"	EXISTING SIGNS RETAIN	EXISTING SIGNS SALVAGE FROM	EXISTING SIGNS SALVAGE TO	EXISTING SIGNS REMOVE	EXIST POST RETAIN	EXIST POST REMOVE	NUMBER OF NEW POSTS	SQUARE STEEL (IN) 1.75 (LB / FT) 1.88	SQUARE STEEL (IN) 2.00 (LB / FT) 2.42	SQUARE STEEL (IN) 2.50 (LB / FT) 3.35	TUBULAR STEEL Ø (IN) FOUNDATION	TUBULAR STEEL Ø (IN) 3.00 (LB / FT) 7.60	TUBULAR STEEL Ø (IN) 3.50 (LB / FT) 9.00	TUBULAR STEEL Ø (IN) 4.00 (LB / FT) 10.80	TUBULAR STEEL Ø (IN) 5.00 (LB / FT) 14.60	SIGN FRAME REQUIRED	REMARKS	SIGN DETAIL: DETAIL IN SHS	SIGN DETAIL: DETAIL ON SHEET NUMBER	SIGN DETAIL: DETAIL ON STD SHEET NUMBER
WILMINGTON VT 100							FY-FLUORESCENT YELLOW FYG-FLUORESCENT YELLOW GREEN																				"SHS"-STANDARD HIGHWAY SIGNS			
		F	W13-1	18	18		30-MPH (PLAQUE)						1																
SB	6.320	F	W1-3R	30	30		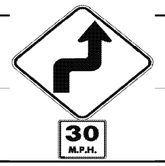	6.25								1		X								INSTALL TO A NEW POSITION 50 FT ± SOUTH OF PREVIOUS LOCATION.	X		
		F	W13-1	18	18			2.25																				X	
SB	6.275	F	W11-7	30	30								1		X														
		F	W11-7P	24	18		XING PLAQUE						1																
		F	W11-7	30	30			6.25								1		X										X	
SB	5.870	G	VR-017	24	30								1		X												OLD ARK RD (TH-14)			
		G	VR-017	24	30			5.00								1		X											E-141
SB	5.862	H	R1-1	30	30								1		X												OLD ARK RD (TH-14)			
		H	R1-1	30	30			6.25								1		X										X	
SB	5.720	F	VD-062AS	72	16		BUSINESS SIGN				~~1~~		1		X												SIGN REMOVED - BUSINESS IS ~~SALVAGE TO M.P. 5.695.~~ CLOSED			
		F	W2-1Mb	36	36	FY		9.00								2		X											6
		F	W16-8a	48	15	FY		5.00																					8
SB	5.695	F	VD-062AS	72	16		BUSINESS SIGN					~~1~~				2		X									BUSINESS IS CLOSED ~~SALVAGED FROM M.P. 5.720. INSTALL 130 SOUTH OF EXISTING LOCATION~~			
SB	5.640	G	VR-017	24	30								1		X												HASKELL HILL RD (TH-80)			
SIGN SUMMARY SHEET							SHEET TOTALS	40.00	0.00	0	0 ~~1~~	0 ~~1~~	7 ~~6~~	0	0	8		120										
VERMONT AGENCY OF TRANSPORTATION								SF	SF	EA	EA	EA	EA	EA	EA	EA		FT										
							TOWN TOTALS	825.4	0.0	64.0	15.0	15.0	145	0.0	0.0	145		2175.0												

PROJECT NAME: **Stamford-Andover VT100**
PROJECT NUMBER: **STPG SIGN(20)**

FILE NAME: **Wilmington.xls**
PROJECT MANAGER: **N. Averv**
DESIGNED BY: **M. Miller**
WILMINGTON SHEET 18

PLOT DATE: **8/6/2009**
DRAWN BY: **T. Guazzoni**
CHECKED BY: **T. Guazzoni**
SHEET **88** OF **198**