DIRECTION	MILEPOINT	LOCATION CODE (SHEET 2)	SIGN CODE	WIDTH (IN)	HEIGHT (IN)	SHEETING REMARKS	SIGN LEGEND	NEW SIGNS "A"	NEW SIGNS "B"	EXISTING SIGNS RETAIN	EXISTING SIGNS SALVAGE FROM	EXISTING SIGNS SALVAGE TO	EXISTING SIGNS REMOVE	EXIST POST RETAIN	EXIST POST REMOVE	NUMBER OF NEW POSTS	SQUARE STEEL (IN) 1.75 (LB / FT) 1.88	SQUARE STEEL (IN) 2.00 (LB / FT) 2.42	SQUARE STEEL (IN) 2.50 (LB / FT) 3.35	FOUNDATION	TUBULAR STEEL Ø (IN) 3.00 (LB / FT) 7.60	TUBULAR STEEL Ø (IN) 3.50 (LB / FT) 9.00	TUBULAR STEEL Ø (IN) 4.00 (LB / FT) 10.80	TUBULAR STEEL Ø (IN) 5.00 (LB / FT) 14.60	SIGN FRAME REQUIRED	REMARKS	SIGN DETAIL: DETAIL IN SHS	SIGN DETAIL: DETAIL ON SHEET NUMBER	SIGN DETAIL: DETAIL ON STD SHEET NUMBER
DOVER VT 100							FY-FLUORESCENT YELLOW FYG-FLUORESCENT YELLOW GREEN																			"SHS"-STANDARD HIGHWAY SIGNS			
NB	0.000	C	VD-024	72	10		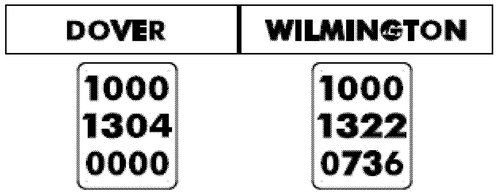	5.00 ~~6.00~~								2		X							INSTALL BEHIND RAIL DIRECTLY ACROSS FROM THE REMOVED SOUTHBOUND SIGN.		4	
		C	VD-700	6	10			0.42																		DOVER MILE MARKER. INSTALL ON THE LEFT SIDE POST UNDER DOVER.			E-138
		C	VD-700	6	10			0.42																		WILMINGTON MILE MARKER. INSTALL ON THE RIGHT SIDE POST UNDER WILMINGTON.			E-138
NB	0.270	A	R2-5A	24	30		REDUCED SPEED AHEAD						1		X														
		A	W3-5	36	36			9.00								2		X									X	
NB	0.360	A	W1-2L	30	30		CURVE LEFT						1		X													
NB	0.400	A	R2-1	24	30								1		X														
		A	R4-1	24	30								1															
		A	R2-1	24	30			5.00								1		X							SPEED LIMIT SIGN ON TOP.	X		
		A	R4-1	24	30		1000 1304 0040	5.00																		SALVAGED MM ONTO NEW POST.	X	
NB	0.450	A	W1-3L	30	30								1		X													
		A	W13-1	18	18								1															
		A	W1-3L	30	30			6.25								1		X									X	
		A	W13-1	18	18			2.25																			X	
NB	0.510	A	W1-6	48	24								1		X													
							SHEET TOTALS	33.34 34.34	0.00	0	0	0	7	0	0	6		90										
								SF	SF	EA	EA	EA	EA	EA	EA	EA		FT										
							TOWN TOTALS	648.1	0.0	30.0	3.0	1.0	116	0.0	0.0	112		1680.0										

SIGN SUMMARY SHEET

VERMONT AGENCY OF TRANSPORTATION

PROJECT NAME: Stamford-Andover VT100
PROJECT NUMBER: STPG SIGN(20)

FILE NAME: Dover.xls
PROJECT MANAGER: N. Avery
DESIGNED BY: M. Miller
DOVER SHEET 1

PLOT DATE: 8/6/2009
DRAWN BY: I. Shea
CHECKED BY: T. Guazzoni