DIRECTION	MILEPOINT	LOCATION CODE (SHEET 2)	SIGN CODE	WIDTH (IN)	HEIGHT (IN)	SHEETING REMARKS	SIGN LEGEND	NEW SIGNS "A"	NEW SIGNS "B"	EXISTING SIGNS RETAIN	EXISTING SIGNS SALVAGE FROM	EXISTING SIGNS SALVAGE TO	EXISTING SIGNS REMOVE	EXIST POST RETAIN	EXIST POST REMOVE	NUMBER OF NEW POSTS	SQUARE STEEL (IN) 1.75 (LB / FT) 1.88	SQUARE STEEL (IN) 2.00 (LB / FT) 2.42	SQUARE STEEL (IN) 2.50 (LB / FT) 3.35	TUBULAR STEEL Ø (IN) FOUNDATION	TUBULAR STEEL Ø (IN) 3.00 (LB / FT) 7.60	TUBULAR STEEL Ø (IN) 3.50 (LB / FT) 9.00	TUBULAR STEEL Ø (IN) 4.00 (LB / FT) 10.80	TUBULAR STEEL Ø (IN) 5.00 (LB / FT) 14.60	SIGN FRAME REQUIRED	REMARKS	SIGN DETAIL: DETAIL IN SHS	SIGN DETAIL: DETAIL ON SHEET NUMBER	SIGN DETAIL: DETAIL ON STD SHEET NUMBER
WARDSBORO VT 100							FY-FLUORESCENT YELLOW FYG-FLUORESCENT YELLOW GREEN																			"SHS"-STANDARD HIGHWAY SIGNS			
		A	W13-1	24	24		20 MPH PLAQUE			1																		
NB	2.240	A	W1-6	48	24								1		X													
		A	W1-6	48	24	FY	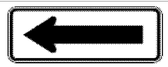	8.00								2		X								X		
NB	2.260	A	W5-2	30	30								1		X													
		A	W5-2	36	36			9.00								~~1~~ 2		X								X		
NB	2.285	A	M3-1S	24	12		NORTH						1		X													
		A	M1-5	30	24		VERMONT 100						1															
		A	M6-1	21	15		<--- LEFT ARROW						1															
NB	2.295	B	W1-6	48	24								1		X													
		B	W1-6	48	24	FY	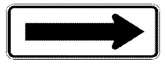	8.00								2		X								FACES SB TRAFFIC	X		
NB	2.297	C	VR-017	24	30		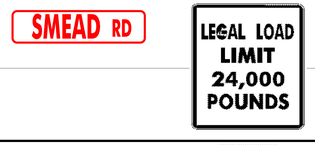						1		X												TH-6, SMEAD RD			
		C	VR-017	24	30			5.00								1		X								STREET SIGN SALVAGED ONTO NEW POST			E-141
NB	2.302	D	R1-1	30	30								1		X												TH-6, SMEAD RD			
		D	R1-1	30	30			6.25								1		X									X		
NB	2.306	A	W1-6	60	30								1		X													
							SHEET TOTALS	36.25 SF	0.00 SF	1 EA	~~0~~ EA	~~0~~ EA	9 EA	0 EA	0 EA	~~7~~ 8 EA		105 FT										
							TOWN TOTALS	633.3	0.0	24.0	12.0	12.0	108	0.0	0.0	129		1935.0										

SIGN SUMMARY SHEET

VERMONT AGENCY OF TRANSPORTATION

PROJECT NAME: **Stamford-Andover VT100**
PROJECT NUMBER: **STPG SIGN(20)**

FILE NAME: **Wardsboro.xls**
PROJECT MANAGER: **N. Averv**
DESIGNED BY: **J. Kelly**
WARDSBORO SHEET 4

PLOT DATE: **8/6/2009**
DRAWN BY: **T. Guazzoni**
CHECKED BY: **T. Guazzoni**
SHEET **122** OF **198**