DIRECTION	MILEPOINT	LOCATION CODE (SHEET 2)	SIGN CODE	WIDTH (IN)	HEIGHT (IN)	SHEETING REMARKS	SIGN LEGEND	NEW SIGNS "A"	NEW SIGNS "B"	EXISTING SIGNS RETAIN	EXISTING SIGNS SALVAGE FROM	EXISTING SIGNS SALVAGE TO	EXISTING SIGNS REMOVE	EXIST POST RETAIN	EXIST POST REMOVE	NUMBER OF NEW POSTS	SQUARE STEEL (IN) 1.75 (LB / FT) 1.88	SQUARE STEEL (IN) 2.00 (LB / FT) 2.42	SQUARE STEEL (IN) 2.50 (LB / FT) 3.35	TUBULAR STEEL Ø (IN) FOUNDATION	TUBULAR STEEL Ø (IN) 3.00 (LB / FT) 7.60	TUBULAR STEEL Ø (IN) 3.50 (LB / FT) 9.00	TUBULAR STEEL Ø (IN) 4.00 (LB / FT) 10.80	TUBULAR STEEL Ø (IN) 5.00 (LB / FT) 14.60	SIGN FRAME REQUIRED	REMARKS	SIGN DETAIL: DETAIL IN SHS	SIGN DETAIL: DETAIL ON SHEET NUMBER	SIGN DETAIL: DETAIL ON STD SHEET NUMBER
WARDSBORO VT 100							FY-FLUORESCENT YELLOW FYG-FLUORESCENT YELLOW GREEN																			"SHS"-STANDARD HIGHWAY SIGNS			
		F	D1-1A	72	10								1																
		F	D1-1A	72	12			6.00								2		X										5	
		F	D1-1A	72	12		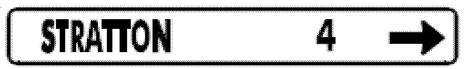	6.00																				5	
SB	2.143	G	VR-017	24	30								1		X															
		G	VR-017	24	30			5.00								1		X									TH-1, STRATTON-ARLINGTON RD			E-141
SB	2.138	H	R1-1	30	30								1		X															
		H	R1-1	30	30			6.25			I	I				1		X									TH-1, STRATTON-ARLINGTON RD	X		
SB	2.115	F	M3-3S	24	12		SOUTH						1		X														
		F	M1-5	30	24		VERMONT 100						1																
		F	R2-1	24	30			5.00								1		X										X		
SB	2.077	F	M3-3	24	12			2.00								1		X									INSTALL 200 FT± SOUTH OF THE NEW SPEED LIMIT SIGN. GREEN ON WHITE SHEETING	X		
		F	M1-5	30	24			5.00																						E-136B
SB	2.040	F	R2-1	24	30		SPEED LIMIT 50						1		X															
SB	1.900	F	W1-2R	30	30		RIGHT CURVE				1		I		X															
		F	W13-1	18	18		35 MPH PLAQUE				1		I																	
SIGN SUMMARY SHEET							SHEET TOTALS	35.25	0.00	0	~~3~~ 2	I ~~0~~	~~8~~ 6	0	0	6		90											
VERMONT AGENCY OF TRANSPORTATION								SF	SF	EA	EA	EA	EA	EA	EA	EA		FT										
							TOWN TOTALS	633.3	0.0	24.0	12.0	12.0	108	0.0	0.0	129		1935.0											

PROJECT NAME: **Stamford-Andover VT100**
PROJECT NUMBER: **STPG SIGN(20)**

FILE NAME: **Wardsboro.xls**
PROJECT MANAGER: **N. Avery**
DESIGNED BY: **J. Kelly**
WARDSBORO SHEET 17

PLOT DATE: **8/6/2009**
DRAWN BY: **T. Guazzoni**
CHECKED BY: **T. Guazzoni**
SHEET **135** OF **198**