DIRECTION	MILEPOINT	LOCATION CODE (SHEET 2)	SIGN CODE	WIDTH (IN)	HEIGHT (IN)	SHEETING REMARKS	SIGN LEGEND	NEW SIGNS "A"	NEW SIGNS "B"	EXISTING SIGNS RETAIN	EXISTING SIGNS SALVAGE FROM	EXISTING SIGNS SALVAGE TO	EXISTING SIGNS REMOVE	EXIST POST RETAIN	EXIST POST REMOVE	NUMBER OF NEW POSTS	SQUARE STEEL (IN) 1.75 (LB / FT) 1.88	SQUARE STEEL (IN) 2.00 (LB / FT) 2.42	SQUARE STEEL (IN) 2.50 (LB / FT) 3.35	TUBULAR STEEL Ø (IN) FOUNDATION	TUBULAR STEEL Ø (IN) 3.00 (LB / FT) 7.60	TUBULAR STEEL Ø (IN) 3.50 (LB / FT) 9.00	TUBULAR STEEL Ø (IN) 4.00 (LB / FT) 10.80	TUBULAR STEEL Ø (IN) 5.00 (LB / FT) 14.60	SIGN FRAME REQUIRED	REMARKS	SIGN DETAIL: DETAIL IN SHS	SIGN DETAIL: DETAIL ON SHEET NUMBER	SIGN DETAIL: DETAIL ON STD SHEET NUMBER
JAMAICA VT 100							FY-FLUORESCENT YELLOW FYG-FLUORESCENT YELLOW GREEN																			"SHS"-STANDARD HIGHWAY SIGNS			
		F	W1-6	48	24	FY		8.00								2		X									X		
SB	0.603	E	W1-6	48	24								MISSING ~~1~~		X														
		E	W1-6	48	24	FY		8.00								2		X									X		
SB	0.587	F	W1-6	48	24								1		X														
		F	W1-6	48	24	FY		8.00																		X		
SB	0.586	E	W1-6	48	24								1		X														
		E	W1-6	48	24	FY	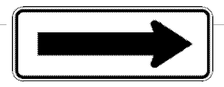	8.00								2		X									X		
SB	0.325	F	VW-060	30	30								1																
		F	VW-060	30	30	FY		6.25								1		X									E-154
SB	0.032	F	W3-5	36	36		SPEED REDUCTION 40 MPH AHEAD			1				X															
			VT 100 RESUMES																										
NB	3.600	B	R1-1	30	30		STOP 1000 1309 0360						1		X														
NB	3.630	A	M3-1S	24	12								1		X														
		A	M1-5	30	24								1																
		A	M3-1	24	12			2.00								1		X								GREEN ON WHITE SHEETING	X		
SIGN SUMMARY SHEET							SHEET TOTALS	40.25 SF	0.00 SF	1 EA	0 EA	0 EA	6 EA	0 EA	0 EA	8 EA		120 FT										
VERMONT AGENCY OF TRANSPORTATION							TOWN TOTALS	391.9	0.0	33.0	4.0	4.0	69	0.0	0.0	66		990.0										

PROJECT NAME: **Stamford-Andover VT100**
PROJECT NUMBER: **STPG SIGN(20)**

FILE NAME: **Jamaica.xls**
PROJECT MANAGER: **N. Averv**
DESIGNED BY: **M. Miller**
JAMAICA SHEET 8

PLOT DATE: **8/6/2009**
DRAWN BY: **T. Guazzoni**
CHECKED BY: **T. Guazzoni**
SHEET **144** OF **198**