DIRECTION	MILEPOINT	LOCATION CODE (SHEET 2)	SIGN CODE	WIDTH (IN)	HEIGHT (IN)	SHEETING REMARKS	SIGN LEGEND	NEW SIGNS "A"	NEW SIGNS "B"	EXISTING SIGNS RETAIN	EXISTING SIGNS SALVAGE FROM	EXISTING SIGNS SALVAGE TO	EXISTING SIGNS REMOVE	EXIST POST RETAIN	EXIST POST REMOVE	NUMBER OF NEW POSTS	SQUARE STEEL (IN) 1.75 (LB / FT) 1.88	SQUARE STEEL (IN) 2.00 (LB / FT) 2.42	SQUARE STEEL (IN) 2.50 (LB / FT) 3.35	FOUNDATION	TUBULAR STEEL Ø (IN) 3.00 (LB / FT) 7.60	TUBULAR STEEL Ø (IN) 3.50 (LB / FT) 9.00	TUBULAR STEEL Ø (IN) 4.00 (LB / FT) 10.80	TUBULAR STEEL Ø (IN) 5.00 (LB / FT) 14.60	SIGN FRAME REQUIRED	REMARKS	SIGN DETAIL: DETAIL IN SHS	SIGN DETAIL: DETAIL ON SHEET NUMBER	SIGN DETAIL: DETAIL ON STD SHEET NUMBER
LONDONDERRY VT 100							FY-FLUORESCENT YELLOW FYG-FLUORESCENT YELLOW GREEN																			"SHS"-STANDARD HIGHWAY SIGNS			
		A	VD-018	30	18			3.75								1		X										E-128A
NB	2.795	A	W1-3R	48	48								1		X													
		A	W13-1	24	24		20 MPH PLAQUE 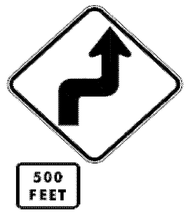						1															
		A	W1-3R	36	36	FY		9.00								2		X								X		
		A	W16-2	24	18	FY		3.00																	INSTALL ON LEFT POST	X		
NB	2.890 ~~2.846~~	A	R2-1	30 ~~24~~	36 ~~30~~		SPEED LIMIT 30														SIGN ALREADY INSTALLED. SEE SIGN CHANGE NOTE ON SHEET #151							
~~NB~~	~~2.875~~	~~A~~	~~R2-1~~	~~30~~	~~36~~			~~7.50~~								~~1~~		~~X~~			SEE NOTE ABOVE				~~INSTALL150 FEET NORTH OF EXISTING SPEED LIMIT 30 SIGN, NORTH OF TH-27.~~		6	
NB	2.910	A	W1-3R	30	30	FY		6.25								1		X							INSTALL 80 FEET SOUTH OF END OF GUARDRAIL.	X		
		A	W13-1	18	18	FY		2.25																		X		
		C	VR-017	24	30		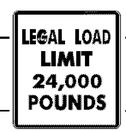	5.00					1			1		X							TH-48, W RIVER ST			E-141
NB	2.952	D	R1-1	30	30								1		X										TH-48, W RIVER ST			
		D	R1-1	30	30		1000 1310 0294	6.25								1		X								X		
NB	2.953	A	D1-1A	72	10		<--- LONDONDERRY 3						1		X													
NB	2.983	A	M3-1S	24	12								1		X													
		A	M1-5	30	24								1															
							SHEET TOTALS	35.50 ~~43.00~~	0.00	0	0	0	7 ~~6~~	0	0	7		105										
								SF	SF	EA	EA	EA	EA	EA	EA	EA		FT										
							TOWN TOTALS	729.7	0.0	22.0	4.0	4.0	151	0.0	0.0	118		1770.0										

SIGN SUMMARY SHEET

VERMONT AGENCY OF TRANSPORTATION

PROJECT NAME: Stamford-Andover VT100
PROJECT NUMBER: STPG SIGN(20)

FILE NAME: Londonderry.xls
PROJECT MANAGER: N. Avery
DESIGNED BY: J. Kelly
LONDONDERRY SHEET 3

PLOT DATE: 8/6/2009
DRAWN BY: T. Guazzoni
CHECKED BY: T. Guazzoni
SHEET 152 OF 198