DIRECTION	MILEPOINT	LOCATION CODE (SHEET 2)	SIGN CODE	WIDTH (IN)	HEIGHT (IN)	SHEETING REMARKS	SIGN LEGEND	NEW SIGNS "A"	NEW SIGNS "B"	EXISTING SIGNS RETAIN	EXISTING SIGNS SALVAGE FROM	EXISTING SIGNS SALVAGE TO	EXISTING SIGNS REMOVE	EXIST POST RETAIN	EXIST POST REMOVE	NUMBER OF NEW POSTS	SQUARE STEEL (IN) 1.75 (LB / FT) 1.88	SQUARE STEEL (IN) 2.00 (LB / FT) 2.42	SQUARE STEEL (IN) 2.50 (LB / FT) 3.35	TUBULAR STEEL Ø (IN) FOUNDATION	TUBULAR STEEL Ø (IN) 3.00 (LB / FT) 7.60	TUBULAR STEEL Ø (IN) 3.50 (LB / FT) 9.00	TUBULAR STEEL Ø (IN) 4.00 (LB / FT) 10.80	TUBULAR STEEL Ø (IN) 5.00 (LB / FT) 14.60	SIGN FRAME REQUIRED	REMARKS	SIGN DETAIL: DETAIL IN SHS	SIGN DETAIL: DETAIL ON SHEET NUMBER	SIGN DETAIL: DETAIL ON STD SHEET NUMBER
LONDONDERRY VT 100							FY-FLUORESCENT YELLOW FYG-FLUORESCENT YELLOW GREEN																			"SHS"-STANDARD HIGHWAY SIGNS			
		A	M1-5	24	24								1															
		A	M5-1S	21	15								1															
		A	M3-1S	24	12								1															
		A	M1-5	30	24								1															
		A	M5-1S	21	15								1															
		A	M3-4	24	12			2.00																	#3A	GREEN ON WHITE SHEETING	X	7	
		A	M1-5	24	24			4.00																				E-136B
		A	M6-1L	21	15			2.19																		GREEN ON WHITE SHEETING	X		
		A	M3-2	24	12			2.00																		GREEN ON WHITE SHEETING	X		
		A	M1-5	24	24		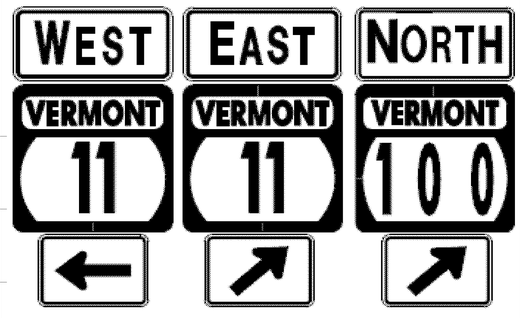	4.00																		E-136B
		A	M6-2R	21	15			2.19																		GREEN ON WHITE SHEETING	X		
		A	M3-1	24	12			2.00																		GREEN ON WHITE SHEETING	X		
		A	M1-5	30	24			5.00																				E-136B
		A	M6-2R	21	15			2.19																		GREEN ON WHITE SHEETING	X		
NB	5.795	A	R1-1	36	36		STOP 1000 1310 0581			1				X														
							SHEET TOTALS	25.57 SF	0.00 SF	1 EA	0 EA	0 EA	5 EA	0 EA	0 EA	0 EA			0 FT									
							TOWN TOTALS	729.7	0.0	22.0	4.0	4.0	151	0.0	0.0	118			1770.0									

SIGN SUMMARY SHEET

VERMONT AGENCY OF TRANSPORTATION

PROJECT NAME: **Stamford-Andover VT100**
PROJECT NUMBER: **STPG SIGN(20)**

FILE NAME: **Londonderrv.xls** PLOT DATE: **8/6/2009**
PROJECT MANAGER: **N. Averv** DRAWN BY: **T. Guazzoni**
DESIGNED BY: **J. Kelly** CHECKED BY: **T. Guazzoni**
LONDONDERRY SHEET 9 SHEET **158** OF **198**