DIRECTION	MILEPOINT	LOCATION CODE (SHEET 2)	SIGN CODE	WIDTH (IN)	HEIGHT (IN)	SHEETING REMARKS	SIGN LEGEND	NEW SIGNS "A"	NEW SIGNS "B"	EXISTING SIGNS RETAIN	EXISTING SIGNS SALVAGE FROM	EXISTING SIGNS SALVAGE TO	EXISTING SIGNS REMOVE	EXIST POST RETAIN	EXIST POST REMOVE	NUMBER OF NEW POSTS	SQUARE STEEL (IN) 1.75 (LB / FT) 1.88	SQUARE STEEL (IN) 2.00 (LB / FT) 2.42	SQUARE STEEL (IN) 2.50 (LB / FT) 3.35	TUBULAR STEEL Ø (IN) FOUNDATION	TUBULAR STEEL Ø (IN) 3.00 (LB / FT) 7.60	TUBULAR STEEL Ø (IN) 3.50 (LB / FT) 9.00	TUBULAR STEEL Ø (IN) 4.00 (LB / FT) 10.80	TUBULAR STEEL Ø (IN) 5.00 (LB / FT) 14.60	SIGN FRAME REQUIRED	REMARKS	SIGN DETAIL: DETAIL IN SHS	SIGN DETAIL: DETAIL ON SHEET NUMBER	SIGN DETAIL: DETAIL ON STD SHEET NUMBER
WESTON VT 100							FY-FLUORESCENT YELLOW FYG-FLUORESCENT YELLOW GREEN																			"SHS"-STANDARD HIGHWAY SIGNS			
		A	R8-3A	24	24		NO PARKING SYMBOL						1															
		A	R2-1	24	30			5.00								1		X								INSTALL SIGN ON TOP	X		
		C	VR-052	24	30			5.00																					7
NB	3.360	A	D1-1A	54	7.5		ANDOVER 5 --->						1		X														
		A	W1-10L	30	30			6.25								1		X										X	
NB	3.363	C	VR-052L	24	30		DOUBLE NO PARKING (~~LEFT~~ ARROW)						1		X														
		C	VR-052	24	30			5.00								1		X											7
NB	3.405	C	VR-052R	24	30		NO PARKING RIGHT ARROW 1000 1421 0000						1		X														
RETAINED SIGN. SEE SHEET # 194																													
NB	3.405	A	M3-1S	24	12								1		X														
		A	M1-5	30	24		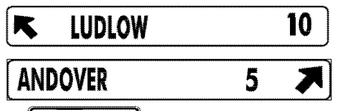						1																
		A	M6-2S	21	15								1																
		A	D1-1A	72	12			6.00								2		X											5
		A	D1-1A	72	12			6.00																					5
		A	M3-1	24	12			2.00																			GREEN ON WHITE SHEETING	X		
		A	M1-5	30	24			5.00																						E-136B
							SHEET TOTALS	40.25 SF	0.00 SF	0 EA	0 EA	0 EA	7 EA	0 EA	0 EA	5 EA			75 FT									
							TOWN TOTALS	774.4	0.0	26.0	12.0	12.0	139	0.0	0.0	140			2100.0									

SIGN SUMMARY SHEET

VERMONT AGENCY OF TRANSPORTATION

PROJECT NAME: **Stamford-Andover VT100**
PROJECT NUMBER: **STPG SIGN(20)**

FILE NAME: **Weston.xls**
PROJECT MANAGER: **N. Averv**
DESIGNED BY: **J. Kelly**
WESTON SHEET 6

PLOT DATE: **8/6/2009**
DRAWN BY: **T. Guazzoni**
CHECKED BY: **T. Guazzoni**
SHEET **177** OF **198**