DIRECTION	MILEPOINT	LOCATION CODE (SHEET 2)	SIGN CODE	WIDTH (IN)	HEIGHT (IN)	SHEETING REMARKS	SIGN LEGEND	NEW SIGNS "A"	NEW SIGNS "B"	EXISTING SIGNS RETAIN	EXISTING SIGNS SALVAGE FROM	EXISTING SIGNS SALVAGE TO	EXISTING SIGNS REMOVE	EXIST POST RETAIN	EXIST POST REMOVE	NUMBER OF NEW POSTS	SQUARE STEEL (IN) 1.75 (LB / FT) 1.88	SQUARE STEEL (IN) 2.00 (LB / FT) 2.42	SQUARE STEEL (IN) 2.50 (LB / FT) 3.35	TUBULAR STEEL Ø (IN) FOUNDATION	TUBULAR STEEL Ø (IN) 3.00 (LB / FT) 7.60	TUBULAR STEEL Ø (IN) 3.50 (LB / FT) 9.00	TUBULAR STEEL Ø (IN) 4.00 (LB / FT) 10.80	TUBULAR STEEL Ø (IN) 5.00 (LB / FT) 14.60	SIGN FRAME REQUIRED	REMARKS	SIGN DETAIL: DETAIL IN SHS	SIGN DETAIL: DETAIL ON SHEET NUMBER	SIGN DETAIL: DETAIL ON STD SHEET NUMBER
WESTON VT 100							FY-FLUORESCENT YELLOW FYG-FLUORESCENT YELLOW GREEN																				"SHS"-STANDARD HIGHWAY SIGNS			
		F	W13-1	18	18			2.25																		X		
SB	3.260	G	VR-052	24	30								1		X														
		G	VR-052	24	30			5.00								1		X										7	
SB	3.244	F	W1-8	18	24		CHEVRON			1				X															
NEW SIGN. SEE SHEET # 194																													
SB	3.210	H	R1-1	30	30								1		X												TH-8, PARK ST		
		H	R1-1	30	30		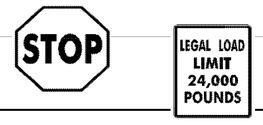	6.25								1		X							(INTERSECTION ISLAND)	X		
		G	VR-017	24	30			5.00																			INSTALL ON BACK SIDE OF STOP SIGN IN ISLAND		
SB	3.210	F	W1-8	18	24		CHEVRON				1	1			X	1		X									RETAIN SIGN AND INSTALL ON NEW POST.		
SB	3.200	H	R1-1	30	30								1		X												TH-8, PARK ST		
		H	R1-1	30	30			6.25								1		X								X		
SB	3.195	F	R2-1	24	30		SPEED LIMIT 30			~~1~~			1	~~X~~	X												THIS SIGN WAS REMOVED. APPROVED BY M. MILLER ON 6/17/10		
SB	3.170	G	VR-052R	12	18		NO PARKING (RIGHT ARROW)				1				X												RELOCATE SOUTH TO INTERSECTION ISLAND AT M.P. 3.155		
		G	VR-052	24	30			5.00								1		X										7	
SB	3.160	G	VR-017	24	30								1		X												TH-2, LAWRENCE HILL RD		
		G	VR-017	24	30			5.00								1		X										E-141	
SIGN SUMMARY SHEET							SHEET TOTALS	34.75	0.00	2	2	1	4	0	0	6		90									
								SF	SF	EA	EA	EA	EA	EA	EA	EA		FT									
VERMONT AGENCY OF TRANSPORTATION							TOWN TOTALS	774.4	0.0	26.0	12.0	12.0	139	0.0	0.0	140		2100.0									

PROJECT NAME: **Stamford-Andover VT100**
PROJECT NUMBER: **STPG SIGN(20)**

FILE NAME: **Weston.xls**
PROJECT MANAGER: **N. Avery**
DESIGNED BY: **J. Kelly**
WESTON SHEET 18

PLOT DATE: **8/6/2009**
DRAWN BY: **T. Guazzoni**
CHECKED BY: **T. Guazzoni**
SHEET **189** OF **198**