DIRECTION	MILEPOINT	LOCATION CODE (SHEET 2)	SIGN CODE	WIDTH (IN)	HEIGHT (IN)	SHEETING REMARKS	SIGN LEGEND	NEW SIGNS "A"	NEW SIGNS "B"	EXISTING SIGNS RETAIN	EXISTING SIGNS SALVAGE FROM	EXISTING SIGNS SALVAGE TO	EXISTING SIGNS REMOVE	EXIST POST RETAIN	EXIST POST REMOVE	NUMBER OF NEW POSTS	SQUARE STEEL (IN) 1.75 (LB / FT) 1.88	SQUARE STEEL (IN) 2.00 (LB / FT) 2.42	SQUARE STEEL (IN) 2.50 (LB / FT) 3.35	TUBULAR STEEL Ø (IN) FOUNDATION	TUBULAR STEEL Ø (IN) 3.00 (LB / FT) 7.60	TUBULAR STEEL Ø (IN) 3.50 (LB / FT) 9.00	TUBULAR STEEL Ø (IN) 4.00 (LB / FT) 10.80	TUBULAR STEEL Ø (IN) 5.00 (LB / FT) 14.60	SIGN FRAME REQUIRED	REMARKS	SIGN DETAIL: DETAIL IN SHS	SIGN DETAIL: DETAIL ON SHEET NUMBER	SIGN DETAIL: DETAIL ON STD SHEET NUMBER
DERBY VT 105							FY-FLUORESCENT YELLOW FYG-FLUORESCENT YELLOW GREEN																			"SHS"-STANDARD HIGHWAY SIGNS			
EB	0.035	A	n/a	n/a	n/a		EMPTY 3" TUBULAR STEEL POST								X											REMOVE EMPTY POST ~ 3" TUBULAR STEEL			
EB	0.045	A	M3-2	24	12		EAST																					
		A	M1-5A	24	24		VERMONT ROUTE 105																					
		A	M3-3	24	12		SOUTH																					
		A	M1-5A	24	24		VERMONT ROUTE 5A																					
		A	M3-2	24	12			2.00								1		15 X							GREEN ON WHITE SHEETING. INSTALL 60 FEET ± EAST OF EMPTY POST JUST REMOVED.	X		
		A	M1-5	30	24			5.00																				E-136B
EB	0.075	A	D2-1	72	10								1		X			9		4-25-II (DAMAGED POST)								
		A	D2-1	72	12		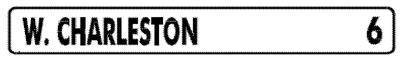	6.00								2		13 13 X								5	
EB	0.135	A	R2-1	24	30								1		X														
		A	R2-1	24	30			5.00								1		13.5 X								X		
EB	0.260	A	S1-1YG	30	30		PENTAGONAL SCHOOL SYMBOL			1				X														
		A	W16-9YG	24	12		AHEAD (PLAQUE)			1																		
EB	0.375	A	M2-1	21	15								1		X													
		A	M1-5	30	24								1															
SIGN SUMMARY SHEET							SHEET TOTALS	18.00 SF	0.00 SF	2 EA	0 EA	0 EA	4 EA	0 EA	0 EA	4 EA		~~60~~ 63.5 FT										
VERMONT AGENCY OF TRANSPORTATION							TOWN TOTALS	421.4	0.0	7.0	1.0	1.0	90	0.0	0.0	62		930.0										

PROJECT NAME: **Derby-Bloomfield VT105**
PROJECT NUMBER: **STPG SIGN(22)**

FILE NAME: **Derby.xls**
PROJECT MANAGER: **N. Averv**
DESIGNED BY: **M. Miller**
DERBY SHEET 1

PLOT DATE: **6/11/2009**
DRAWN BY: **T. Guazzoni**
CHECKED BY: **S. Menard**
SHEET **8** OF **79**