DIRECTION	MILEPOINT	LOCATION CODE (SHEET 2)	SIGN CODE	WIDTH (IN)	HEIGHT (IN)	SHEETING REMARKS	SIGN LEGEND	NEW SIGNS "A"	NEW SIGNS "B"	EXISTING SIGNS RETAIN	EXISTING SIGNS SALVAGE FROM	EXISTING SIGNS SALVAGE TO	EXISTING SIGNS REMOVE	EXIST POST RETAIN	EXIST POST REMOVE	NUMBER OF NEW POSTS	SQUARE STEEL (IN) 1.75 (LB / FT) 1.88	SQUARE STEEL (IN) 2.00 (LB / FT) 2.42	SQUARE STEEL (IN) 2.50 (LB / FT) 3.35	FOUNDATION	TUBULAR STEEL Ø (IN) 3.00 (LB / FT) 7.60	TUBULAR STEEL Ø (IN) 3.50 (LB / FT) 9.00	TUBULAR STEEL Ø (IN) 4.00 (LB / FT) 10.80	TUBULAR STEEL Ø (IN) 5.00 (LB / FT) 14.60	SIGN FRAME REQUIRED	REMARKS	SIGN DETAIL: DETAIL IN SHS	SIGN DETAIL: DETAIL ON SHEET NUMBER	SIGN DETAIL: DETAIL ON STD SHEET NUMBER
DERBY VT 105							FY-FLUORESCENT YELLOW FYG-FLUORESCENT YELLOW GREEN																			"SHS"-STANDARD HIGHWAY SIGNS			
		A	M2-1	21	15			2.19								1		14.5 X							GREEN ON WHITE SHEETING	X		
		A	M1-5	30	24			5.00																				E-136B
EB	0.415	A	W11-2	30	30								1		X													
		A	W11-2	30	30	FYG		6.25								1		15 X								X		
		A	W16-9P	24	12	FYG		2.00																		X		
EB	0.445	A	D1-1A	54	7.5								1		X													
		A	D1-1A	54	7.5								1															
		A	D1-1A	54	7.5								1															
		A	D1-1A	72	12		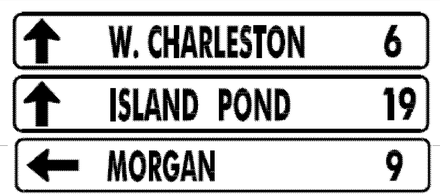	6.00								2		14 14 X									5	
		A	D1-1A	72	12			6.00																			5	
		A	D1-1A	72	12			6.00																			5	
EB	0.470	A	M3-2	24	12		EAST						1		X													
		A	M1-5A	24	24		VT ROUTE 111						1															
		A	M6-1	21	15		LEFT ARROW						1															
		A	M3-2	24	12		EAST						1															
							SHEET TOTALS	33.44	0.00	0	0	0	8	0	0	4		~~60~~ 57.5										
								SF	SF	EA	EA	EA	EA	EA	EA	EA		FT										
							TOWN TOTALS	421.4	0.0	7.0	1.0	1.0	90	0.0	0.0	62		930.0										

SIGN SUMMARY SHEET

VERMONT AGENCY OF TRANSPORTATION

PROJECT NAME: Derby-Bloomfield VT105
PROJECT NUMBER: STPG SIGN(22)

FILE NAME: Derby.xls
PROJECT MANAGER: N. Avery
DESIGNED BY: M. Miller
DERBY SHEET 2

PLOT DATE: 6/11/2009
DRAWN BY: T. Guazzoni
CHECKED BY: S. Menard
SHEET 9 OF 79