DIRECTION	MILEPOINT	LOCATION CODE (SHEET 2)	SIGN CODE	WIDTH (IN)	HEIGHT (IN)	SHEETING REMARKS	SIGN LEGEND	NEW SIGNS "A"	NEW SIGNS "B"	EXISTING SIGNS RETAIN	EXISTING SIGNS SALVAGE FROM	EXISTING SIGNS SALVAGE TO	EXISTING SIGNS REMOVE	EXIST POST RETAIN	EXIST POST REMOVE	NUMBER OF NEW POSTS	SQUARE STEEL (IN) 1.75 (LB / FT) 1.88	SQUARE STEEL (IN) 2.00 (LB / FT) 2.42	SQUARE STEEL (IN) 2.50 (LB / FT) 3.35	FOUNDATION	TUBULAR STEEL Ø (IN) 3.00 (LB / FT) 7.60	TUBULAR STEEL Ø (IN) 3.50 (LB / FT) 9.00	TUBULAR STEEL Ø (IN) 4.00 (LB / FT) 10.80	TUBULAR STEEL Ø (IN) 5.00 (LB / FT) 14.60	SIGN FRAME REQUIRED	REMARKS	SIGN DETAIL: DETAIL IN SHS	SIGN DETAIL: DETAIL ON SHEET NUMBER	SIGN DETAIL: DETAIL ON STD SHEET NUMBER
DERBY VT 105							FY-FLUORESCENT YELLOW FYG-FLUORESCENT YELLOW GREEN																			"SHS"-STANDARD HIGHWAY SIGNS			
		D	R1-1	30	30			6.25								1		14 X								X	
EB	0.730	A	M3-2	24	12		EAST						1		X													
		A	M1-5	30	24		VT ROUTE 105						1															
		A	M3-3	24	12		SOUTH						1															
		A	M1-5	24	24		VT ROUTE 5A						1													ROUTE 5A SIGNS BEING ELIMINATED			
		A	M3-2	24	12			2.00								1		14.5 X							GREEN ON WHITE SHEETING	X		
		A	M1-5	30	24			5.00																				E-136B
EB	0.760	A	R2-1	24	30			5.00								1		13 X								INSTALL 150 FT ± EAST OF THE PREVIOUS ASSEMBLY	X	
EB	1.200	A	R2-1	24	30								1		X														
		A	R2-1	24	30			5.00								1		13.8 X									X	
EB	1.400	A	R2-1	24	30								1		X														
		A	R2-1	24	30			5.00								1		15 X									X	
EB	1.541	C	VR-017	24	24								1		X											SALEM DERBY ROAD (TH-45)			
		C	R2-1	18	24		SPEED LIMIT 35				1																	
		C	VR-017	24	30		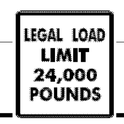	5.00								1		15.5 X									E-141	
							SHEET TOTALS	33.25 SF	0.00 SF	0 EA	1 EA	0 EA	7 EA	0 EA	0 EA	6 EA		~~90~~ 85.8 FT										
							TOWN TOTALS	421.4	0.0	7.0	1.0	1.0	90	0.0	0.0	62		930.0										

SIGN SUMMARY SHEET

VERMONT AGENCY OF TRANSPORTATION

PROJECT NAME: **Derby-Bloomfield VT105**
PROJECT NUMBER: **STPG SIGN(22)**

FILE NAME: **Derbv.xls**
PROJECT MANAGER: **N. Averv**
DESIGNED BY: **M. Miller**
DERBY SHEET 5

PLOT DATE: **6/11/2009**
DRAWN BY: **T. Guazzoni**
CHECKED BY: **S. Menard**
SHEET **12** OF **79**