DIRECTION	MILEPOINT	LOCATION CODE (SHEET 2)	SIGN CODE	WIDTH (IN)	HEIGHT (IN)	SHEETING REMARKS	SIGN LEGEND	NEW SIGNS "A"	NEW SIGNS "B"	EXISTING SIGNS RETAIN	EXISTING SIGNS SALVAGE FROM	EXISTING SIGNS SALVAGE TO	EXISTING SIGNS REMOVE	EXIST POST RETAIN	EXIST POST REMOVE	NUMBER OF NEW POSTS	SQUARE STEEL (IN) 1.75 (LB / FT) 1.88	SQUARE STEEL (IN) 2.00 (LB / FT) 2.42	SQUARE STEEL (IN) 2.50 (LB / FT) 3.35	TUBULAR STEEL Ø (IN) FOUNDATION	TUBULAR STEEL Ø (IN) 3.00 (LB / FT) 7.60	TUBULAR STEEL Ø (IN) 3.50 (LB / FT) 9.00	TUBULAR STEEL Ø (IN) 4.00 (LB / FT) 10.80	TUBULAR STEEL Ø (IN) 5.00 (LB / FT) 14.60	SIGN FRAME REQUIRED	REMARKS	SIGN DETAIL: DETAIL IN SHS	SIGN DETAIL: DETAIL ON SHEET NUMBER	SIGN DETAIL: DETAIL ON STD SHEET NUMBER
DERBY VT 105							FY-FLUORESCENT YELLOW FYG-FLUORESCENT YELLOW GREEN																			"SHS"-STANDARD HIGHWAY SIGNS			
		C	R2-1	18	24		SPEED LIMIT 35					1														INSTALL THE TOWN-OWNED SPEED LIMIT 35 SIGN UNDER THE LEGAL LOAD LIMIT SIGN.			
EB	1.537	D	R1-1	30	30						2		1		X											SALEM DERBY ROAD (TH-45)			
		D	R1-1	30	30			6.25				2				1		14.3 X								X		
EB	2.100	A	W1-2R	30	30		RIGHT CURVE						1		X													
		A	W13-1	18	18		35 MPH (PLAQUE)						1															
EB	2.180	A	S3-1	30	30								1		X													
		A	S3-1	30	30			6.25								1		14.5 X								X		
EB	2.220	A	W1-2R	30	30			6.25								1		15 X							INSTALL 200 FT ± EAST OF SCHOOL BUS STOP AHEAD SIGN.	X		
EB	2.320	A	VW-219	30	30								1		X													
		A	VW-219	30	30			6.25								1		13.5 X									6	
EB	2.997	A	W2-2MaL	30	30		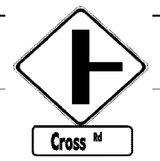	6.25								1		16.8 X							INSTALL 200 FT ± IN ADVANCE OF (WEST OF) THE HINGED SNOWMOBILE CROSSING SIGN		6	
		A	W16-8	24	8			1.33																	CROSS RD (PLAQUE)		7	
EB	3.035	A	W11-6H	30	30		SNOWMOBILE CROSSING SIGN (HINGED)						1		X													
EB	3.116	C	VR-017	24	24								1		X											CROSS ROAD (TH-49)			
		C	VR-017	24	30			5.00								1		13.3 X										E-141
							SHEET TOTALS	37.58 SF	0.00 SF	0 EA	~~0~~ 2 EA	~~1~~ 3 EA	7 EA	0 EA	0 EA	6 EA		~~90~~ 87.4 FT									
							TOWN TOTALS	421.4	0.0	7.0	1.0	1.0	90	0.0	0.0	62		930.0									

SIGN SUMMARY SHEET

VERMONT AGENCY OF TRANSPORTATION

PROJECT NAME: **Derby-Bloomfield VT105**
PROJECT NUMBER: **STPG SIGN(22)**

FILE NAME: **Derby.xls**
PROJECT MANAGER: **N. Avery**
DESIGNED BY: **M. Miller**
DERBY SHEET 6

PLOT DATE: **6/11/2009**
DRAWN BY: **T. Guazzoni**
CHECKED BY: **S. Menard**
SHEET **13** OF **79**