DIRECTION	MILEPOINT	LOCATION CODE (SHEET 2)	SIGN CODE	WIDTH (IN)	HEIGHT (IN)	SHEETING REMARKS	SIGN LEGEND	NEW SIGNS "A"	NEW SIGNS "B"	EXISTING SIGNS RETAIN	EXISTING SIGNS SALVAGE FROM	EXISTING SIGNS SALVAGE TO	EXISTING SIGNS REMOVE	EXIST POST RETAIN	EXIST POST REMOVE	NUMBER OF NEW POSTS	SQUARE STEEL (IN) 1.75 (LB / FT) 1.88	SQUARE STEEL (IN) 2.00 (LB / FT) 2.42	SQUARE STEEL (IN) 2.50 (LB / FT) 3.35	TUBULAR STEEL Ø (IN) FOUNDATION	TUBULAR STEEL Ø (IN) 3.00 (LB / FT) 7.60	TUBULAR STEEL Ø (IN) 3.50 (LB / FT) 9.00	TUBULAR STEEL Ø (IN) 4.00 (LB / FT) 10.80	TUBULAR STEEL Ø (IN) 5.00 (LB / FT) 14.60	SIGN FRAME REQUIRED	REMARKS	SIGN DETAIL: DETAIL IN SHS	SIGN DETAIL: DETAIL ON SHEET NUMBER	SIGN DETAIL: DETAIL ON STD SHEET NUMBER
DERBY VT 105							FY-FLUORESCENT YELLOW FYG-FLUORESCENT YELLOW GREEN																			"SHS"-STANDARD HIGHWAY SIGNS			
		F	D1-1A	72	12		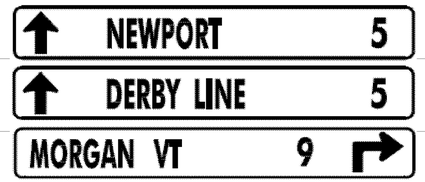	6.00								2		14.3 15 X									5
		F	D1-1A	72	12			6.00																				5
		F	D1-1A	72	12			6.00																			RIGHT ARROW BEING REPLACED WITH 90º ADVANCE RIGHT ARROW		5
WB	0.590	F	W11A-2	30	30								1		X													
		F	W11-2	30	30	FYG		6.25								1		15 X									X
		F	W16-9P	24	12	FYG		2.00																			X	
WB	0.566	F	M3-2	24	12		EAST																					
		F	M1-5A	24	24		VT 105																					
		F	M6-3	21	15		UP ARROW																					
		F	M3-4	24	12		WEST																					
		F	M1-5A	24	24		VT 111																					
		F	M6-1	21	15		RIGHT ARROW																					
		F	M3-2	24	12			2.00								2		15.5 15.8 X								#2B	GREEN ON WHITE SHEETING. INSTALL 100 FT ± WEST OF PED AHEAD WARNING SIGNS; MAINTAIN 10 FT MIN. TO UTILITY POLE GUY WIRE	X	7	
		F	M1-5	30	24			5.00																				E-136B
		F	M6-3	21	15			2.19																			GREEN ON WHITE SHEETING	X	
							SHEET TOTALS	35.44 SF	0.00 SF	0 EA	0 EA	0 EA	1 EA	0 EA	0 EA	5 EA		~~75~~ 75.6 FT									
							TOWN TOTALS	421.4	0.0	7.0	1.0	1.0	90	0.0	0.0	62		930.0									

SIGN SUMMARY SHEET

VERMONT AGENCY OF TRANSPORTATION

PROJECT NAME: **Derby-Bloomfield VT105**
PROJECT NUMBER: **STPG SIGN(22)**

FILE NAME: **Derbv.xls** PLOT DATE: **6/11/2009**
PROJECT MANAGER: **N. Averv** DRAWN BY: **T. Guazzoni**
DESIGNED BY: **M. Miller** CHECKED BY: **S. Menard**
DERBY SHEET 10 SHEET **17** OF **79**