DIR	MILEPOINT	LOCATION CODE (SHEET 2)	SIGN CODE	WIDTH (IN)	HEIGHT (IN)	SHEETING REMARKS	SIGN LEGEND	NEW SIGNS "A"	NEW SIGNS "B"	EXISTING SIGNS RETAIN	EXISTING SIGNS SALVAGE FROM	EXISTING SIGNS SALVAGE TO	EXISTING SIGNS REMOVE	EXIST POST RETAIN	EXIST POST REMOVE	NUMBER OF NEW POSTS	SQUARE STEEL (in) (LB / FT) 1.75 / 1.88	SQUARE STEEL (in) (LB / FT) 2.00 / 2.42	SQUARE STEEL (in) (LB / FT) 2.50 / 3.35	TUBULAR STEEL Ø (IN) FOUNDATION	TUBULAR STEEL Ø (IN) (LB / FT) 3.00 / 7.60	TUBULAR STEEL Ø (IN) (LB / FT) 3.50 / 9.00	TUBULAR STEEL Ø (IN) (LB / FT) 4.00 / 10.80	TUBULAR STEEL Ø (IN) (LB / FT) 5.00 / 14.60	SIGN FRAME REQUIRED	REMARKS	SIGN DETAIL: DETAIL IN SHS	SIGN DETAIL: DETAIL ON SHEET NUMBER	SIGN DETAIL: DETAIL ON STD SHEET NUMBER
CHARLESTON VT 105							FY-FLUORESCENT YELLOW FYG-FLUORESCENT YELLOW GREEN																			"SHS"-STANDARD HIGHWAY SIGNS			
EB	0.695	A	W1-10L	30	30		CURVE LEFT WITH MINOR SIDE ROAD RIGHT						1		X													
EB	0.745	A	W1-2Mc L	30	30			6.25								1		15 X								INSTALL 265 FT EAST OF PREVIOUS CURVE SIGN (STEEP BANK ON RIGHT, BEYOND UTILITY POLES).		6	
		A	W16-8	30	8			1.67																		DANE HILL RD		7	
EB	0.760	A	R2-5A	24	30		REDUCED SPEED AHEAD						1		X													
EB	0.775	A	W3-5	36	36			9.00								2		14.3 13.5 X								INSTALL 80 FEET ± EAST OF PREVIOUS "REDUCED SPEED AHEAD" REMOVAL.	X		
EB	0.810	A	VD-018	30	18		W. CHARLESTON ISLAND POND 12						1		X													
EB	0.824	C	VR-017	24	30								1		X												DANE HILL RD (TH-5). .			
		C	VR-017	24	30			5.00								1		15 X											E-141
EB	0.830	D	R1-1	24	24								1		X												DANE HILL RD (TH-5)			
		D	R1-1	30	30			6.25								1		15 X									X		
EB	0.835	A	M3-2	24	12			2.00								1		15.5 X								GREEN ON WHITE SHEETING. INSTALL 30 FT ± EAST OF POLES / STOP SIGN FOR DANE HILL RD.	X		
		A	M1-5	30	24			5.00																					E-136B
EB	0.850	A	W1-6	48	24								1		X													
		A	W1-6L	48	24		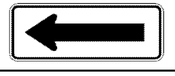	8.00								2		13.5 14 X									X		
EB	0.860	A	W11-2	30	30								1		X													
SIGN SUMMARY SHEET							SHEET TOTALS	43.17	0.00	0	0	0	7	0	0	8		~~120~~ 115.8									
								SF	SF	EA	EA	EA	EA	EA	EA	EA		FT									
VERMONT AGENCY OF TRANSPORTATION							TOWN TOTALS	501.6	0.0	25.0	0.0	0.0	86	0.0	0.0	83		1245.0									

PROJECT NAME: **Derby-Bloomfield VT105**
PROJECT NUMBER: **STGP SIGN(22)**
FILE NAME: **Charleston.xls**
PROJECT MANAGER: **N. Avery**
DESIGNED BY: **M. Miller**
CHARLESTON SHEET 1
PLOT DATE: **6/11/2009**
DRAWN BY: **T. Guazzoni**
CHECKED BY: **S. Menard**
SHEET **22** OF **79**