DIR	MILEPOINT	LOCATION CODE (SHEET 2)	SIGN CODE	WIDTH (IN)	HEIGHT (IN)	SHEETING REMARKS	SIGN LEGEND	NEW SIGNS "A"	NEW SIGNS "B"	EXISTING SIGNS RETAIN	EXISTING SIGNS SALVAGE FROM	EXISTING SIGNS SALVAGE TO	EXISTING SIGNS REMOVE	EXIST POST RETAIN	EXIST POST REMOVE	NUMBER OF NEW POSTS	SQUARE STEEL (in) 1.75 (LB / FT) 1.88	SQUARE STEEL (in) 2.00 (LB / FT) 2.42	SQUARE STEEL (in) 2.50 (LB / FT) 3.35	TUBULAR STEEL Ø (IN) FOUNDATION	TUBULAR STEEL Ø (IN) 3.00 (LB / FT) 7.60	TUBULAR STEEL Ø (IN) 3.50 (LB / FT) 9.00	TUBULAR STEEL Ø (IN) 4.00 (LB / FT) 10.80	TUBULAR STEEL Ø (IN) 5.00 (LB / FT) 14.60	SIGN FRAME REQUIRED	REMARKS	SIGN DETAIL: DETAIL IN SHS	SIGN DETAIL: DETAIL ON SHEET NUMBER	SIGN DETAIL: DETAIL ON STD SHEET NUMBER
CHARLESTON VT 105							FY-FLUORESCENT YELLOW FYG-FLUORESCENT YELLOW GREEN																			"SHS"-STANDARD HIGHWAY SIGNS			
		D	R1-1	30	30			6.25								1		13.3 X								X		
EB	1.500	A	R2-1	24	30								1		X														
		A	R2-1	24	30			5.00								1		13 X								X		
EB	1.960	A	M2-1	21	15		JCT (BLACK ON WHITE)						1		X														
		A	M1-5A	24	24		ROUTE 5A (BLACK ON WHITE)						1																
		A	M2-1	21	15			2.19								1		10.8 X							GREEN ON WHITE SHEETING	X		
		A	M1-5	24	24			4.00																				E-136B
EB	1.995	A	D1-1A	72	10								1		X														
		A	D1-1A	72	10								1																
		A	D1-1A	72	10								1																
		A	D1-1A	72	10								1																
		A	D1-1A	72	12			6.00								2		15.5 14.3 X								5		
		A	D1-1A	72	12			6.00																				5		
		A	D1-1A	72	12			6.00																				5		
		A	D1-1A	72	12		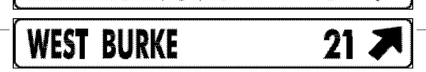	6.00																				5		
							SHEET TOTALS	41.44 SF	0.00 SF	0 EA	0 EA	0 EA	7 EA	0 EA	0 EA	5 EA		~~75~~ 66.9 FT											
							TOWN TOTALS	501.6	0.0	25.0	0.0	0.0	86	0.0	0.0	83		1245.0											

SIGN SUMMARY SHEET

VERMONT AGENCY OF TRANSPORTATION

PROJECT NAME: **Derby-Bloomfield VT105**
PROJECT NUMBER: **STGP SIGN(22)**

FILE NAME: **Charleston.xls**
PROJECT MANAGER: **N. Avery**
DESIGNED BY: **M. Miller**
CHARLESTON SHEET 3

PLOT DATE: **6/11/2009**
DRAWN BY: **T. Guazzoni**
CHECKED BY: **S. Menard**
SHEET **24** OF **79**