DIR	MILEPOINT	LOCATION CODE (SHEET 2)	SIGN CODE	WIDTH (IN)	HEIGHT (IN)	SHEETING REMARKS	SIGN LEGEND	NEW SIGNS "A"	NEW SIGNS "B"	EXISTING SIGNS RETAIN	EXISTING SIGNS SALVAGE FROM	EXISTING SIGNS SALVAGE TO	EXISTING SIGNS REMOVE	EXIST POST RETAIN	EXIST POST REMOVE	NUMBER OF NEW POSTS	SQUARE STEEL (in) 1.75 (LB / FT) 1.88	SQUARE STEEL (in) 2.00 (LB / FT) 2.42	SQUARE STEEL (in) 2.50 (LB / FT) 3.35	FOUNDATION	TUBULAR STEEL Ø (IN) 3.00 (LB / FT) 7.60	TUBULAR STEEL Ø (IN) 3.50 (LB / FT) 9.00	TUBULAR STEEL Ø (IN) 4.00 (LB / FT) 10.80	TUBULAR STEEL Ø (IN) 5.00 (LB / FT) 14.60	SIGN FRAME REQUIRED	REMARKS	SIGN DETAIL: DETAIL IN SHS	SIGN DETAIL: DETAIL ON SHEET NUMBER	SIGN DETAIL: DETAIL ON STD SHEET NUMBER
CHARLESTON VT 105							FY-FLUORESCENT YELLOW FYG-FLUORESCENT YELLOW GREEN																			"SHS"-STANDARD HIGHWAY SIGNS			
EB	2.039	A	M3-2	24	12		EAST (BLACK ON WHITE)						1		X														
		A	M1-5A	24	24		ROUTE 105 (BLACK ON WHITE)						1																
		A	M6-2	21	15		<--- LEFT (45 DEG) (BLACK ON WHITE)						1																
		A	M3-3	24	12		SOUTH (BLACK ON WHITE)						1																
		A	M1-5A	24	24		ROUTE 5A (BLACK ON WHITE)						1																
		A	M6-2	21	15		RIGHT ---> (45 DEG) (BLACK ON WHITE)						1																
		A	M3-2	24	12			2.00								2			14.3 14.7 X						#2A	GREEN ON WHITE SHEETING	X	7	
		A	M1-5	30	24			5.00																					E-136B
		A	M6-2 L	21	15		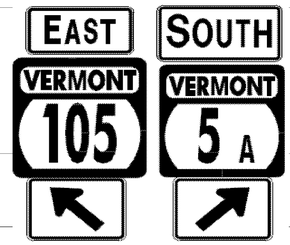	2.19																		GREEN ON WHITE SHEETING	X		
		A	M3-3	24	12			2.00																		GREEN ON WHITE SHEETING	X		
		A	M1-5	24	24			4.00																					E-136B
		A	M6-2 R	21	15			2.19																		GREEN ON WHITE SHEETING	X		
EB	2.054	A	OM1-1	18	18								1		X														
		A	OM1-1	18	18			2.25								1			9.5 X							INSTALL IN PAVED RAISED MEDIAN IN SAME POSITION AS REMOVAL. MOUNT AT 4 FT VERTICAL ~ SEE E-138.	X		(MOUNTING DETAIL E-138)
EB	2.058	D	R1-1	30	30								1		X											VERMONT ROUTE 5A			
							SHEET TOTALS	19.63 SF	0.00 SF	0 EA	0 EA	0 EA	8 EA	0 EA	0 EA	3 EA			~~45~~ 38.5 FT								
							TOWN TOTALS	501.6	0.0	25.0	0.0	0.0	86	0.0	0.0	83			1245.0										

SIGN SUMMARY SHEET

VERMONT AGENCY OF TRANSPORTATION

PROJECT NAME: **Derby-Bloomfield VT105**
PROJECT NUMBER: **STGP SIGN(22)**

FILE NAME: **Charleston.xls** PLOT DATE: **6/11/2009**
PROJECT MANAGER: **N. Avery** DRAWN BY: **T. Guazzoni**
DESIGNED BY: **M. Miller** CHECKED BY: **S. Menard**
CHARLESTON SHEET 4 SHEET **25** OF **79**