DIR	MILEPOINT	LOCATION CODE (SHEET 2)	SIGN CODE	WIDTH (IN)	HEIGHT (IN)	SHEETING REMARKS	SIGN LEGEND	NEW SIGNS "A"	NEW SIGNS "B"	EXISTING SIGNS RETAIN	EXISTING SIGNS SALVAGE FROM	EXISTING SIGNS SALVAGE TO	EXISTING SIGNS REMOVE	EXIST POST RETAIN	EXIST POST REMOVE	NUMBER OF NEW POSTS	SQUARE STEEL (in) 1.75 (LB / FT) 1.88	SQUARE STEEL (in) 2.00 (LB / FT) 2.42	SQUARE STEEL (in) 2.50 (LB / FT) 3.35	TUBULAR STEEL Ø (IN) FOUNDATION	TUBULAR STEEL Ø (IN) 3.00 (LB / FT) 7.60	TUBULAR STEEL Ø (IN) 3.50 (LB / FT) 9.00	TUBULAR STEEL Ø (IN) 4.00 (LB / FT) 10.80	TUBULAR STEEL Ø (IN) 5.00 (LB / FT) 14.60	SIGN FRAME REQUIRED	REMARKS	SIGN DETAIL: DETAIL IN SHS	SIGN DETAIL: DETAIL ON SHEET NUMBER	SIGN DETAIL: DETAIL ON STD SHEET NUMBER
CHARLESTON VT 105							FY-FLUORESCENT YELLOW FYG-FLUORESCENT YELLOW GREEN																			"SHS"-STANDARD HIGHWAY SIGNS			
		H	R1-1	30	30			6.25				1				1		12 X									X		
WB	1.048	F	W1-6	48	24								1		X														
		F	OM1-1	18	18								1																
		F	W1-6L	48	24			8.00								2		12.8 12.8 X									PROVIDE 10 FEET MIN DISTANCE TO UTILITY POLES; ADJUST SIGN LOCATION AS NECESSARY	X		
WB	1.046	E	W1-6	48	24								1		X														
		E	OM1-1	18	18								1																
		E	W1-6R	48	24			8.00								2		12.8 12.8 X									PROVIDE 10 FEET MIN DISTANCE TO UTILITY POLE; ADJUST SIGN LOCATION AS NECESSARY	X		
WB	0.900	F	R2-1	24	30								1		x														
		F	R2-1	24	30			5.00								1		13.5 X									BEHIND RAIL	X		
WB	0.786	F	M3-4	24	12			2.00								1		13.3 X									GREEN ON WHITE SHEETING. INSTALL 200 FT ± WEST OF JCT w/ DANE HILL RD (TH-5).	X		
		F	M1-5	30	24			5.00																				E-136B
WB	0.140	F	W1-2L	30	30		CURVE LEFT 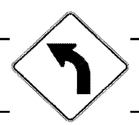						1		X														
WB	0.105	F	W1-2L	30	30			6.25								1		13.5 X									INSTALL 185 FT ± WEST FROM PREVIOUS POSITION. MAINTAIN 10 FT MIN TO UTILITY POLE(S).	X		
WB	0.000	G	VD-024	60	7.5								1		X														
		G	VD-700	6	8								1																
SIGN SUMMARY SHEET							SHEET TOTALS	40.50	0.00	0	0	~~0~~ 1	8	0	0	8		~~120~~ 103.5										
								SF	SF	EA	EA	EA	EA	EA	EA	EA		FT										
VERMONT AGENCY OF TRANSPORTATION							TOWN TOTALS	501.6	0.0	25.0	0.0	0.0	86	0.0	0.0	83		1245.0										

PROJECT NAME: **Derby-Bloomfield VT105**
PROJECT NUMBER: **STGP SIGN(22)**
FILE NAME: **Charleston.xls**
PROJECT MANAGER: **N. Avery**
DESIGNED BY: **M. Miller**
CHARLESTON SHEET 14
PLOT DATE: **6/11/2009**
DRAWN BY: **T. Guazzoni**
CHECKED BY: **S. Menard**
SHEET **35** OF **79**