DIRECTION	MILEPOINT	LOCATION CODE (SHEET 2)	SIGN CODE	WIDTH (IN)	HEIGHT (IN)	SHEETING REMARKS	SIGN LEGEND	NEW SIGNS "A"	NEW SIGNS "B"	EXISTING SIGNS RETAIN	EXISTING SIGNS SALVAGE FROM	EXISTING SIGNS SALVAGE TO	EXISTING SIGNS REMOVE	EXIST POST RETAIN	EXIST POST REMOVE	NUMBER OF NEW POSTS	SQUARE STEEL (IN) 1.75 (LB / FT) 1.88	SQUARE STEEL (IN) 2.00 (LB / FT) 2.42	SQUARE STEEL (IN) 2.50 (LB / FT) 3.35	FOUNDATION	TUBULAR STEEL Ø (IN) 3.00 (LB / FT) 7.60	TUBULAR STEEL Ø (IN) 3.50 (LB / FT) 9.00	TUBULAR STEEL Ø (IN) 4.00 (LB / FT) 10.80	TUBULAR STEEL Ø (IN) 5.00 (LB / FT) 14.60	SIGN FRAME REQUIRED	REMARKS	SIGN DETAIL: DETAIL IN SHS	SIGN DETAIL: DETAIL ON SHEET NUMBER	SIGN DETAIL: DETAIL ON STD SHEET NUMBER
BRIGHTON VT 105							FY-FLUORESCENT YELLOW FYG-FLUORESCENT YELLOW GREEN																			"SHS"-STANDARD HIGHWAY SIGNS			
		A	W16-4	24	18		NEXT 5000 FEET						1															
		A	W13-1	24	24		40 MPH PLAQUE						1															
		A	VW-001	30	30			6.25								1		14.5 X								6	
		A	W7-3A	24	18			3.00																		X	
EB	8.000	A	W1-2L	30	30		LEFT CURVE						1		X													
		A	W13-1	18	18		40 MPH PLAQUE						1															
EB	8.076	A	W1-2L	30	30			6.25								1		14.5 X								INSTALL 400 FEET EAST OF EXISTING ASSEMBLY	X		
		A	W13-1	18	18			2.25																			X	
EB	8.200	A	W1-4R	30	30		RIGHT REVERSE CURVE						1		X													
		A	W13-1	18	18		40 MPH PLAQUE						1															
EB	8.290	A	W1-4R	30	30			6.25								1		15.8 X								INSTALL 475 FEET EAST OF EXISTING ASSEMBLY	X		
		A	W13-1	18	18			2.25																			X	
EB	8.400	A	VW-001	30	30		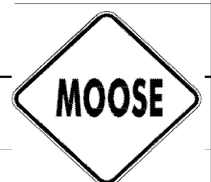	6.25								1		14.8 X								INSTALL NEW BETWEEN CURVES		6	
		A	W7-3A	24	18			3.00																		X	
EB	8.613	C	VR-017	24	24								1		X											HEAD OF THE POND RD TH-13			
							SHEET TOTALS	35.50 SF	0.00 SF	0 EA	0 EA	0 EA	7 EA	0 EA	0 EA	4 EA		~~60~~ 59.6 FT										
							TOWN TOTALS	729.8	0.0	4.0	2.0	2.0	165	0.0	0.0	129		1935.0										

SIGN SUMMARY SHEET

VERMONT AGENCY OF TRANSPORTATION

PROJECT NAME: **Derby-Bloomfield VT105**
PROJECT NUMBER: **STPG SIGN(22)**

FILE NAME: **Brighton.xls**
PROJECT MANAGER: **N. Averv**
DESIGNED BY: **J. Kelly**
BRIGHTON SHEET 12

PLOT DATE: **6/11/2009**
DRAWN BY: **T. Guazzoni**
CHECKED BY: **S. Menard**
SHEET **48** OF **79**